


T.2N.R.3&4W.W.M.

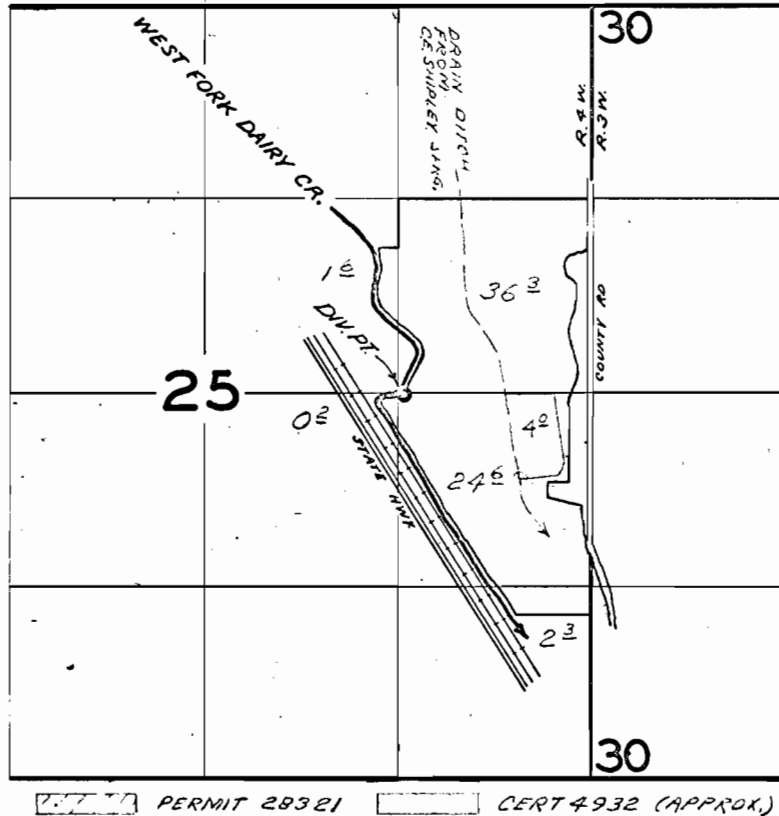

**FINAL PROOF SURVEY**  
UNDER

Application No. 37984 Permit No. 28321  
IN NAME OF

JOSEPH A. EVERS

Surveyed MAY 9 1967, by V. GARNER