


T. I. S. R. I. W. W. M.

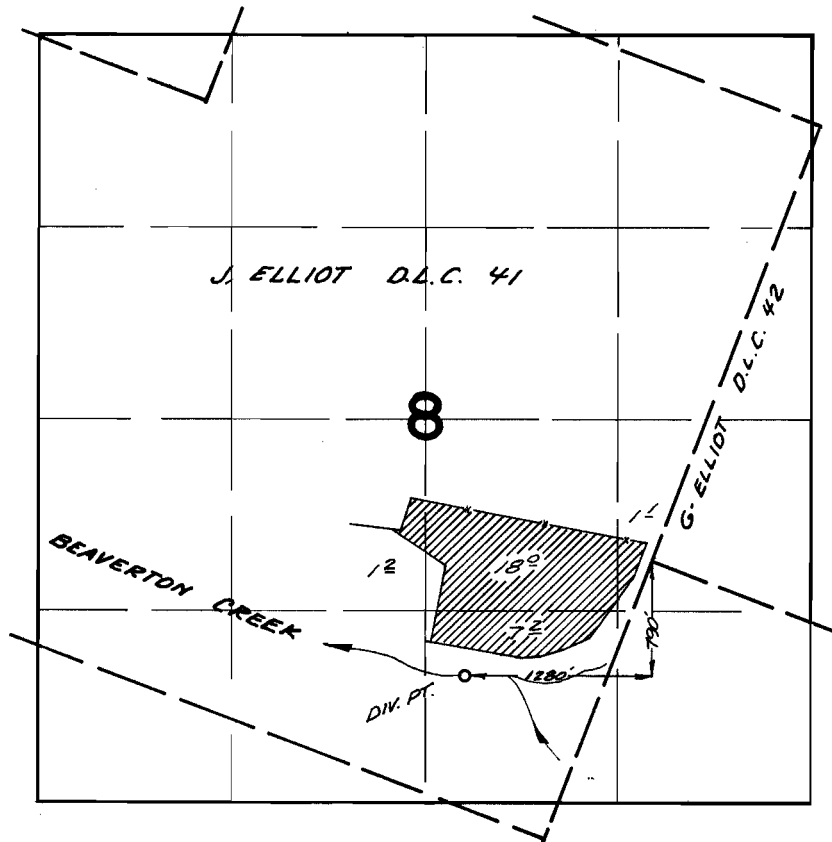

FINAL PROOF SURVEY UNDER

Application No. 40655 Permit No. 30287
IN NAME OF

.....*ST. MARY'S HOME INC.*.....

Surveyed *June 24 1968*, by *V. Garner*.....