


T.11S. R.23E. W.M.

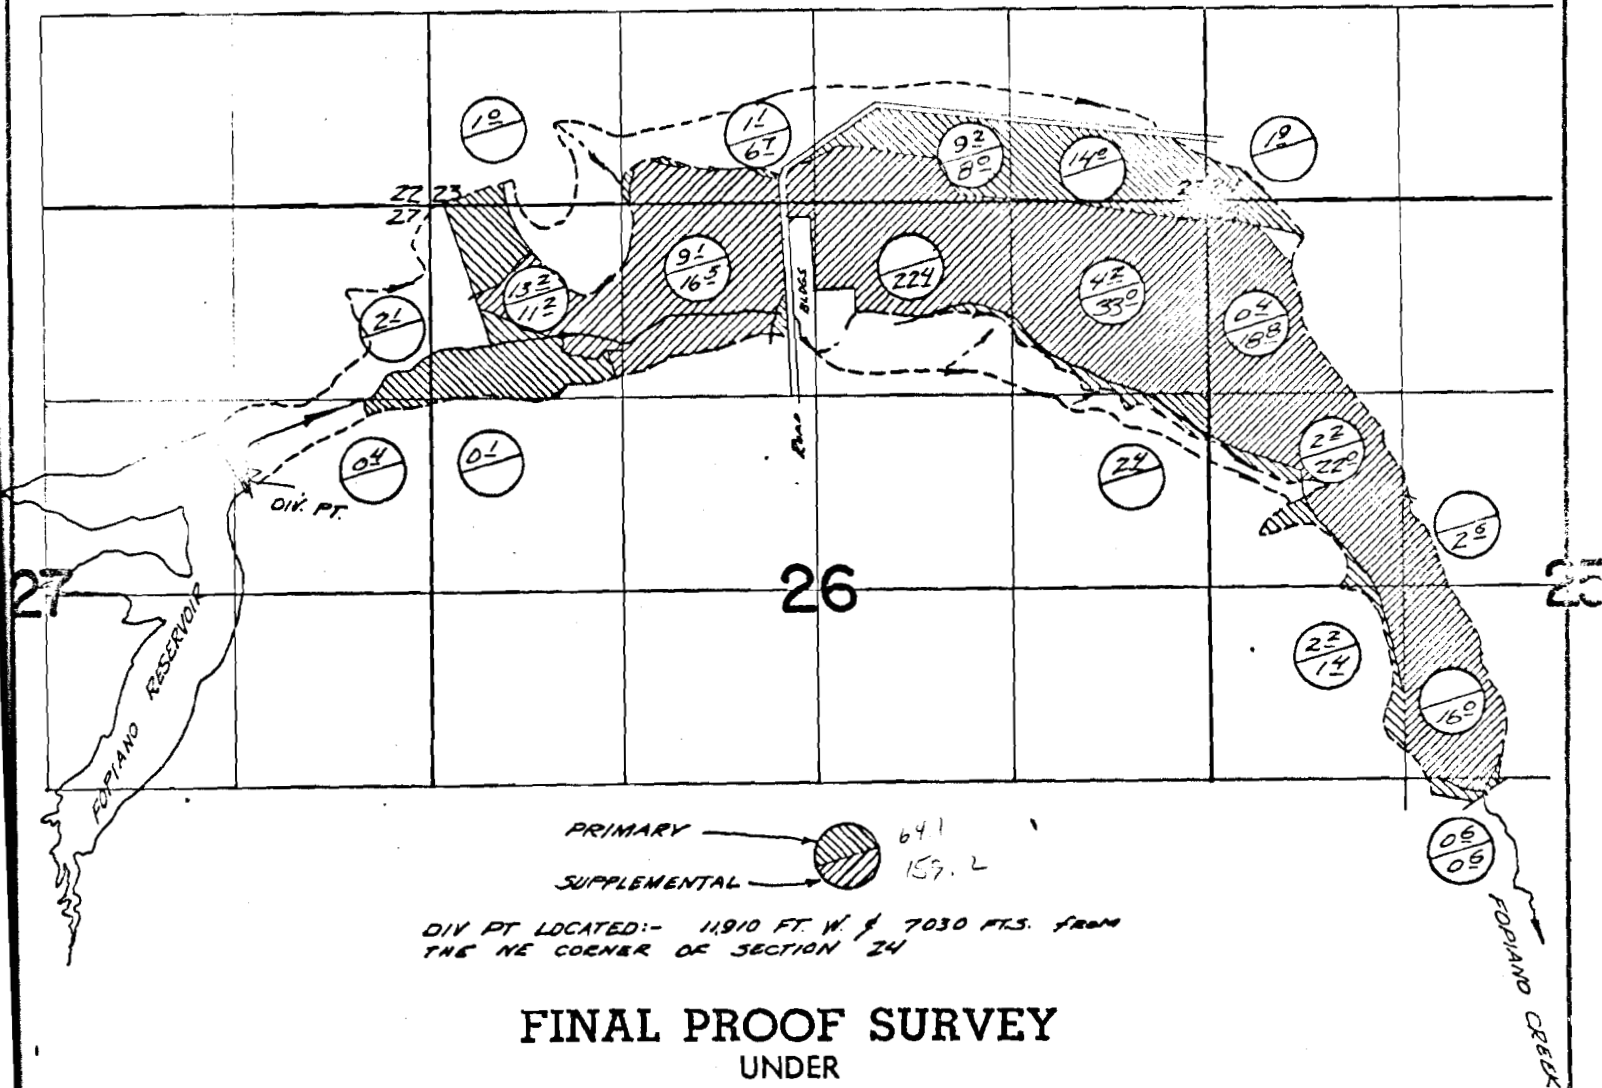

R-20451 R-1986
Application No. 24206 Permit No. 24707
IN NAME OF

LILY F. COLLINS

Surveyed July 19, 1968, by V. Garner