


24707
36574

T11S. R.23E. W.M.

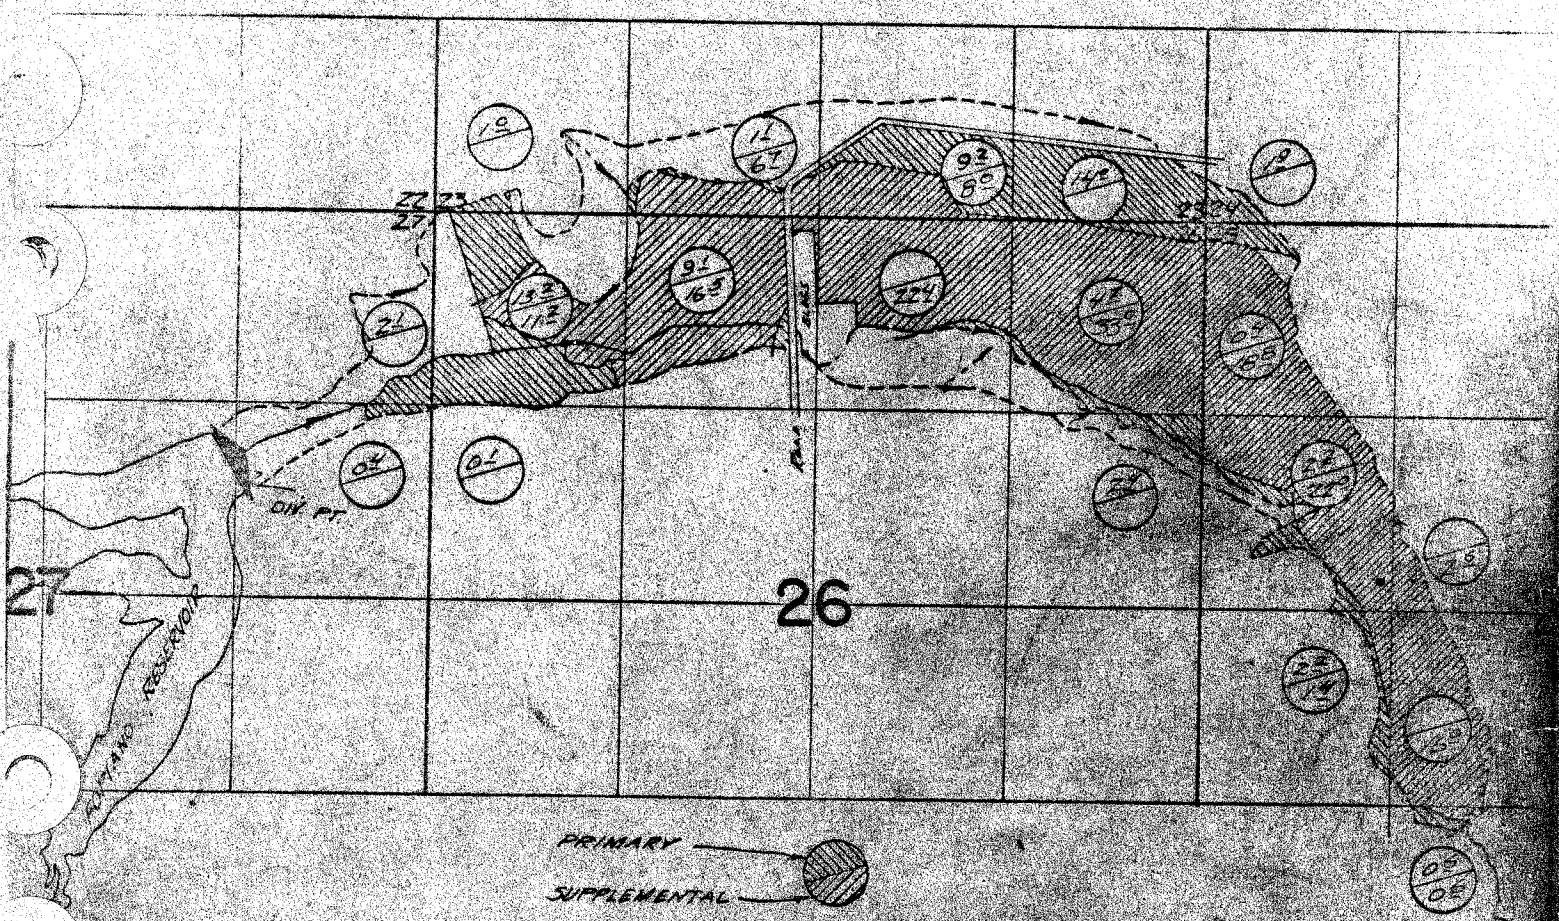

PRIMARY 
SUPPLEMENTAL 

DIV PT LOCATED:- 11910 FT N & 7030 FT E FROM
THE NE CORNER OF SECTION 24

FINAL PROOF SURVEY UNDER

R-20451 R-1985
Application No. 24206 Permit No. 24707
IN NAME OF

LILY F. COLLINS

Surveyed July 19, 1968, by V. Garner