


T.11 S. R.23 & 24E.W.M.

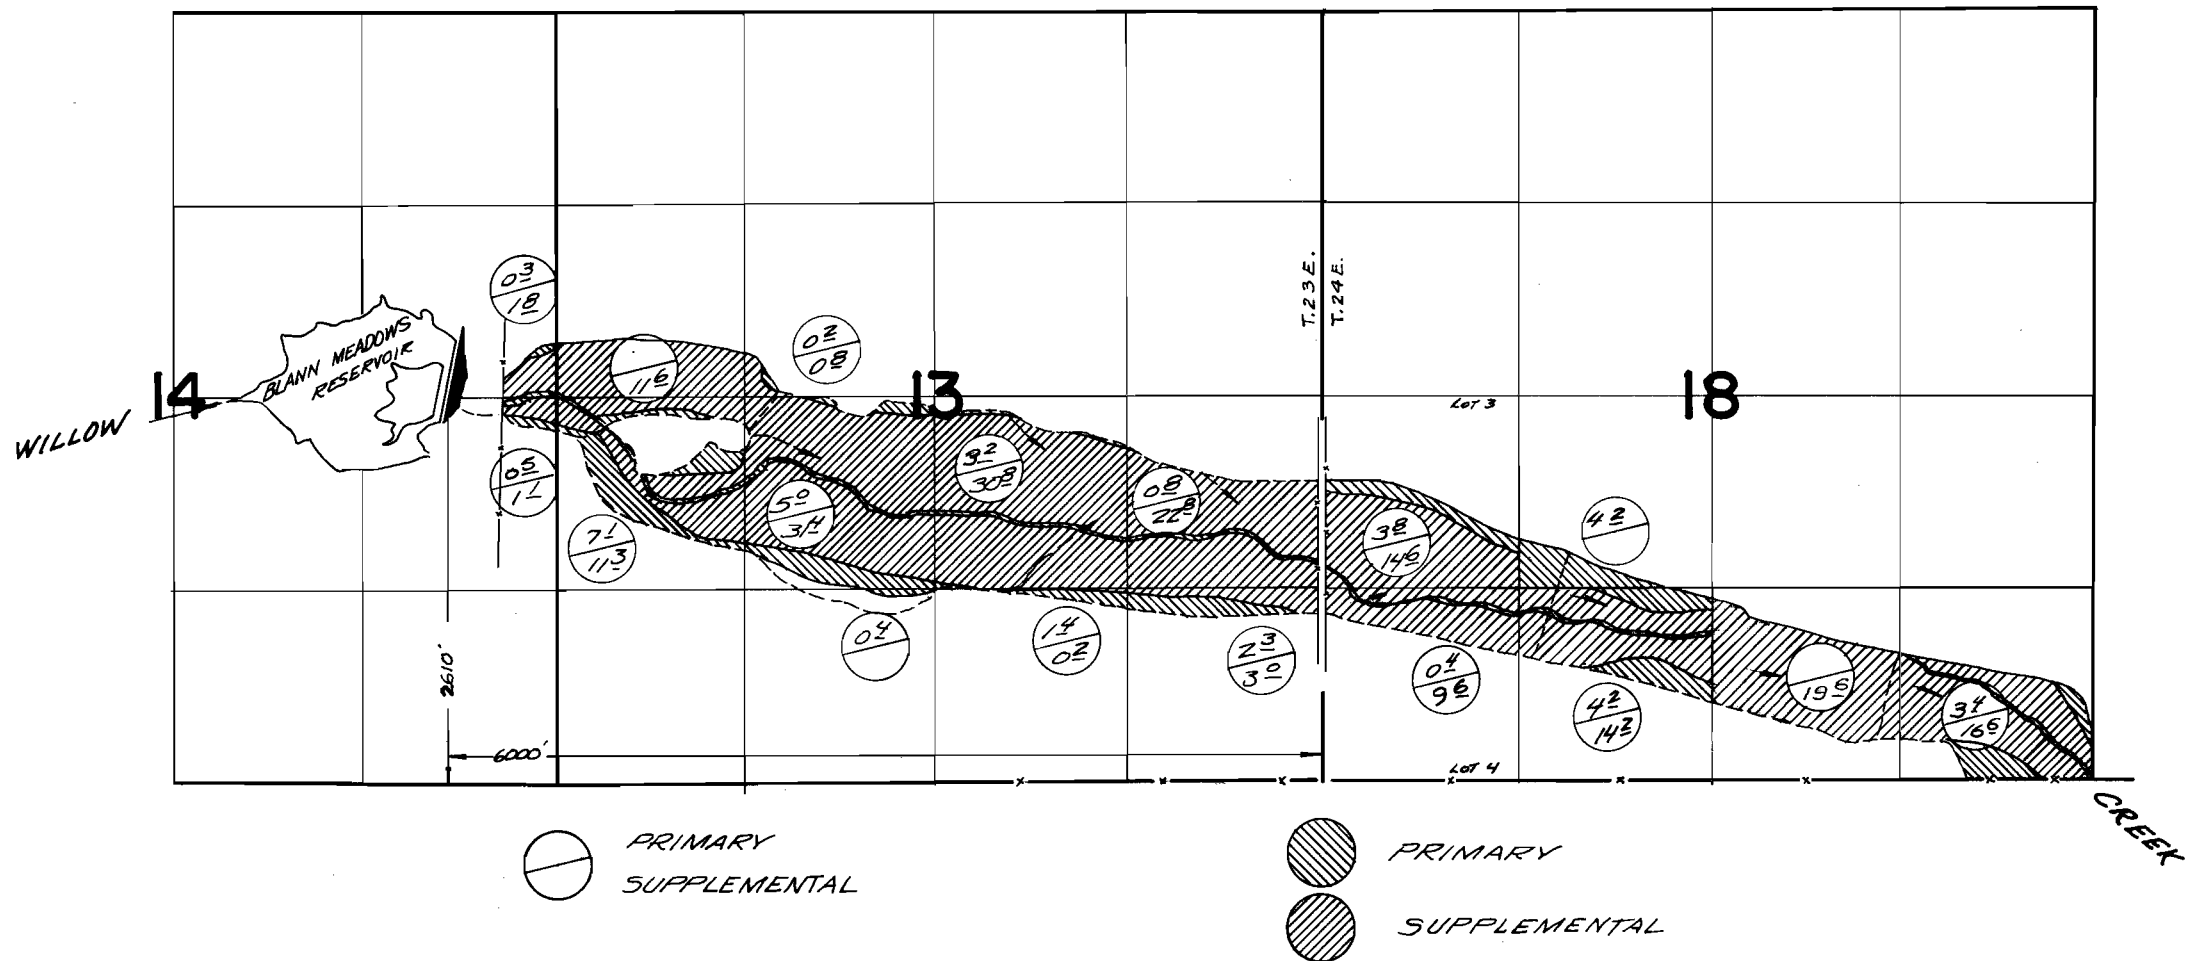

FINAL PROOF SURVEY
UNDER

APPLICATION NO. R-31961 PERMIT NO. R-2100
31962 25237

IN NAME OF
JAMES R. COLLINS

SURVEYED JULY 17, 1968 BY VES GARNER