


27772
36577

T.6 S. R.20E.W.M.

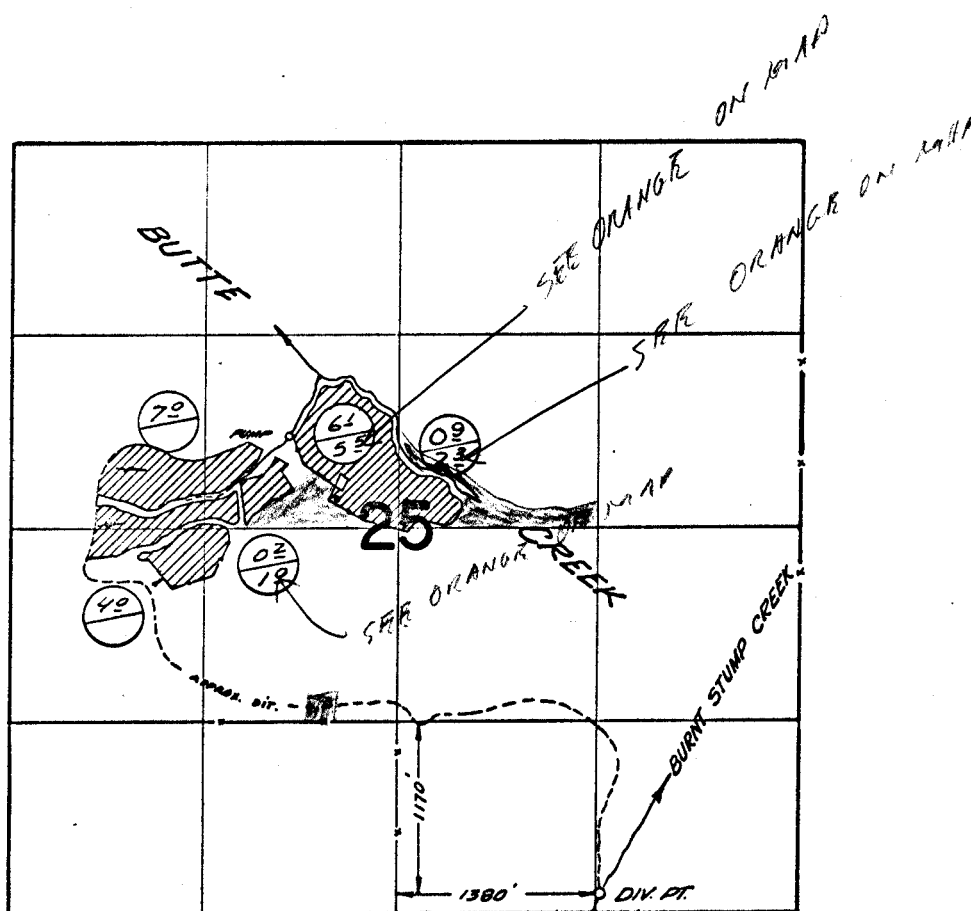

NEW LANDS
LANDS WITH EXISTING RIGHTS

FINAL PROOF SURVEY UNDER

Application No. 37281... Permit No. 27772.
IN NAME OF

HARRY ZACHARY

Surveyed July 9, 1968, by V. Garver