


30159
SUP 36578
76594

T.9S. R. 23 E. W.M.

SEE
SO. V. 34 P. 456

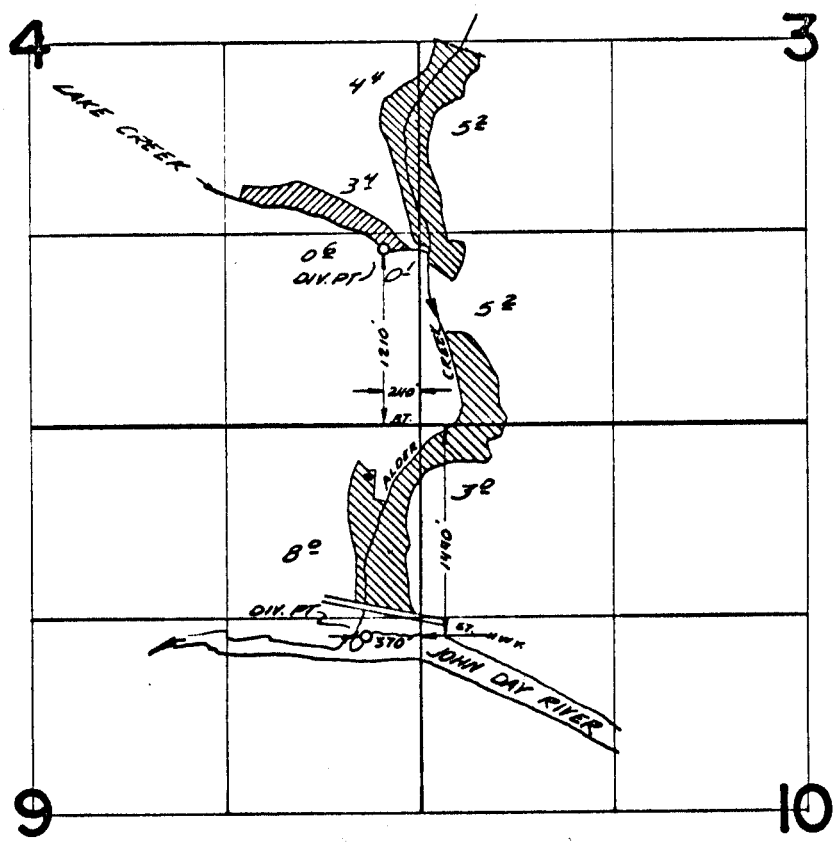

FINAL PROOF SURVEY
UNDER

Application No. 4046B... Permit No. 30159...
IN NAME OF

TRIPLE L. RANCHES, INC.

Surveyed July 15, 1968, by *V. Garner*

1968-C