


T.7 & 8 S. R. 23 E. W.M.

30995
36579

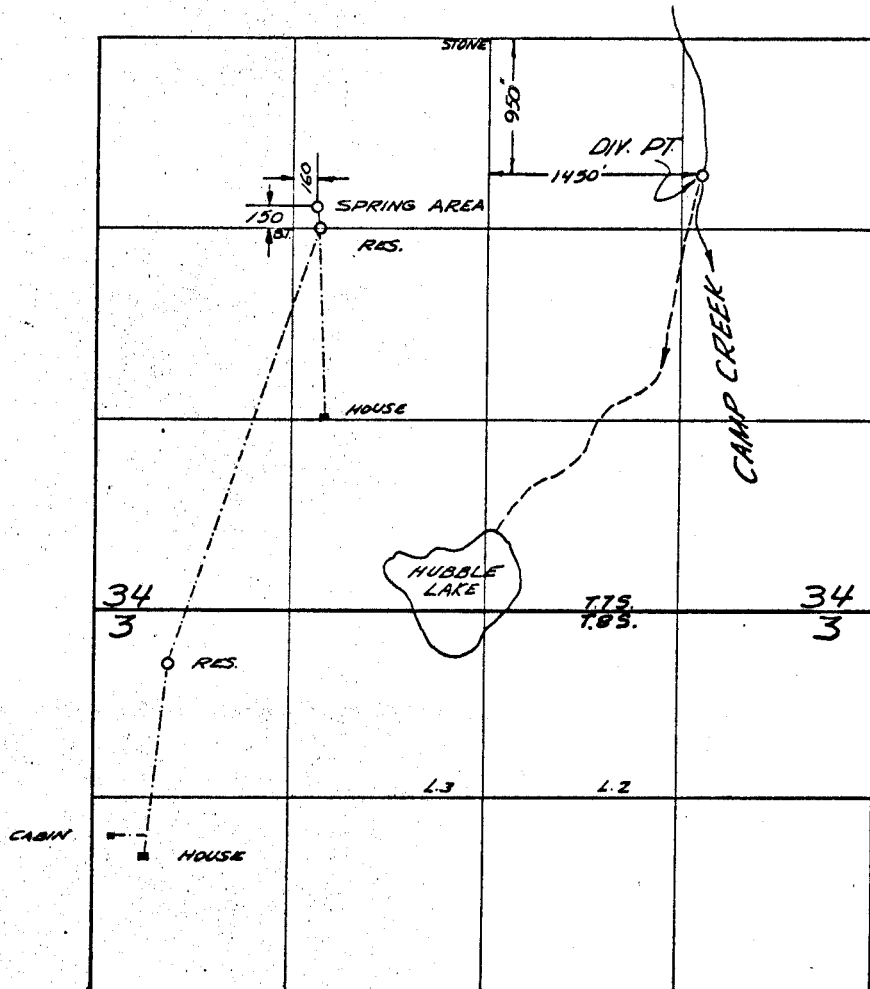

FINAL PROOF SURVEY
UNDER

Application No. 41551... Permit No. 30995...
IN NAME OF

R.D. HOFER

Surveyed July 15, 1968, by V. Garner