


31 154
36580

T.7 S. R.21E. W.M.

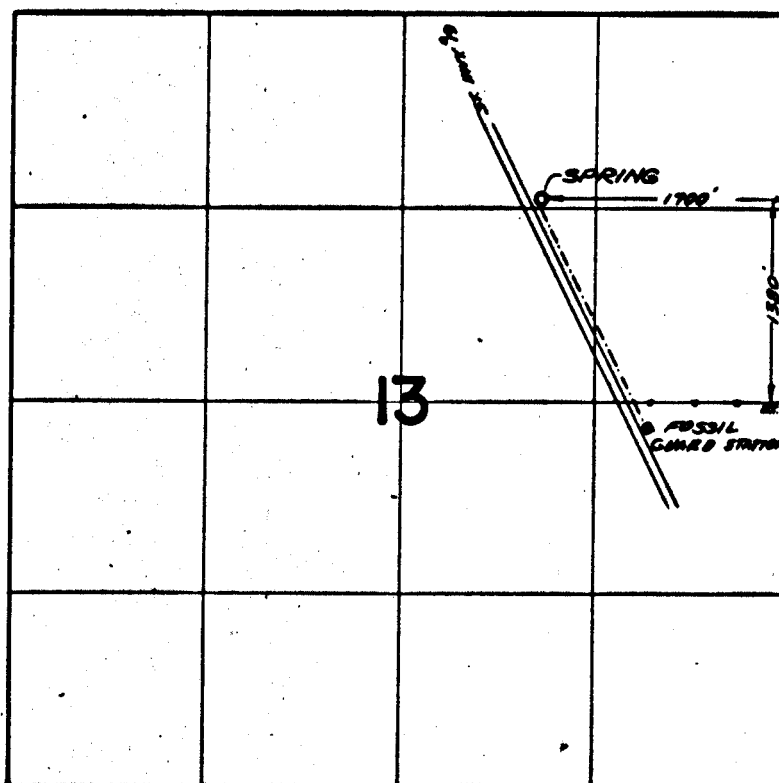

FINAL PROOF SURVEY
UNDER

Application No. 41728 Permit No. 31154
IN NAME OF C. 36580

STATE OF OREGON BOARD OF FORESTRY

Surveyed July 10, 1968, by V. Garner

1968-C