


32232
36581

T.9 S. R.25 E.W.M.

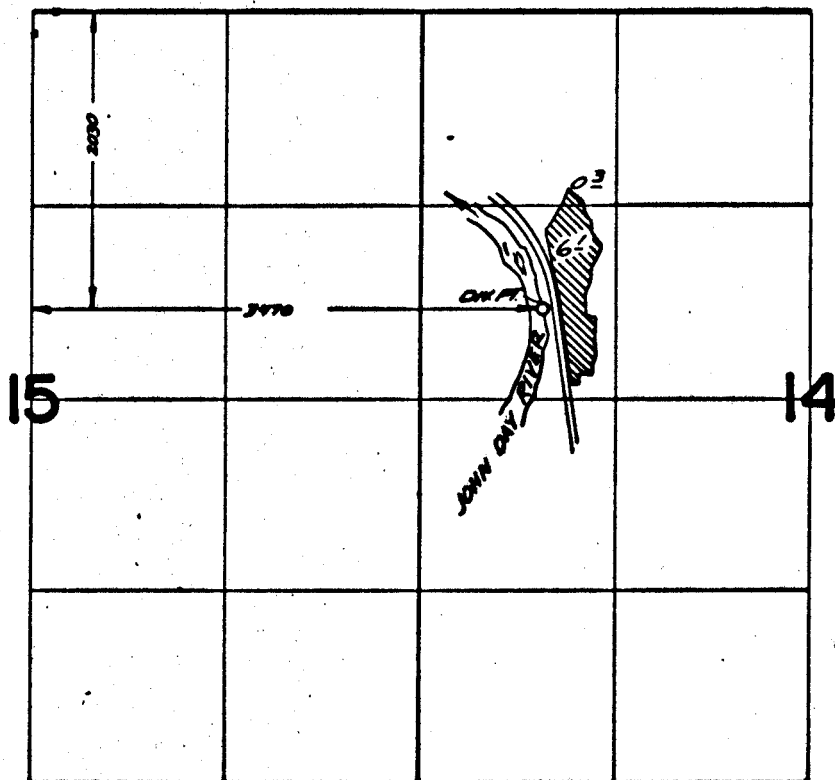

FINAL PROOF SURVEY
UNDER

Application No. 43148 Permit No. 32232
IN NAME OF

CHARLES H. HILL

Surveyed July 13 1968, by V. Garner

1968-C