


*T. 6 S. R. 3 W. W. M*

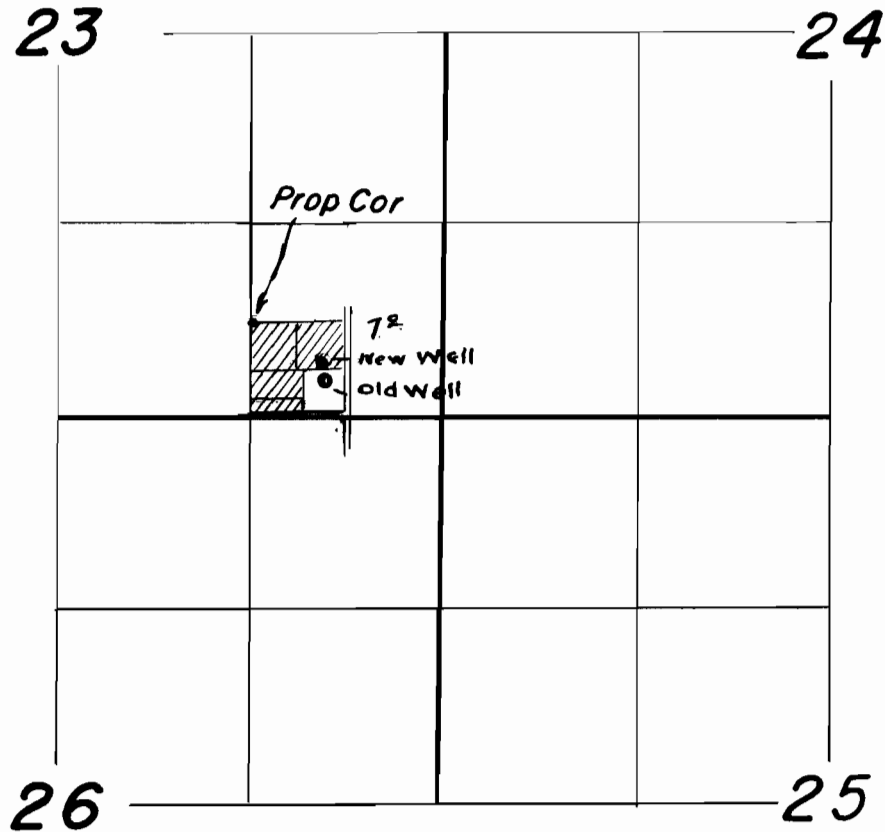

**FINAL PROOF SURVEY**  
UNDER

Application No. G-2199 Permit No. G-2023  
IN NAME OF

Joe W. Oppek

Surveyed June 3 1964, by R. Jackson