


# T. 15. R. 38E. W.M.

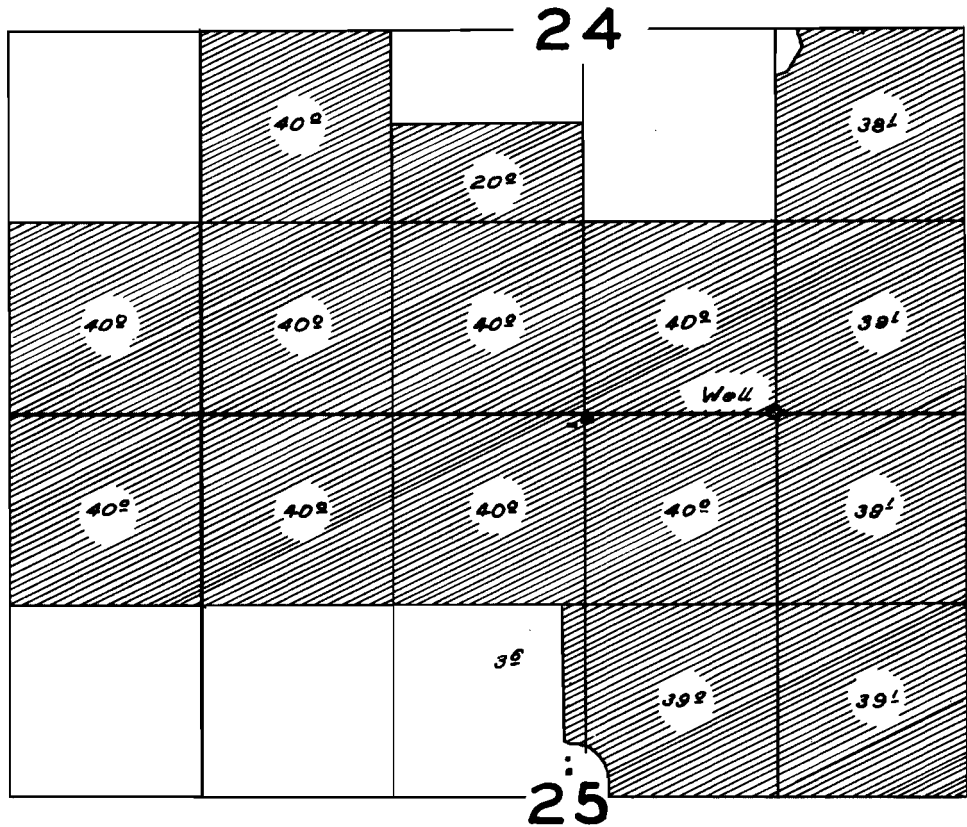

## FINAL PROOF SURVEY UNDER

Application No. *U-335* Permit No. *U-309*  
IN NAME OF

*Marion Wagner*

Surveyed *Aug. 4, 1959*, by *R.H. Jackson*