


T.12S.R.6W.W.M.

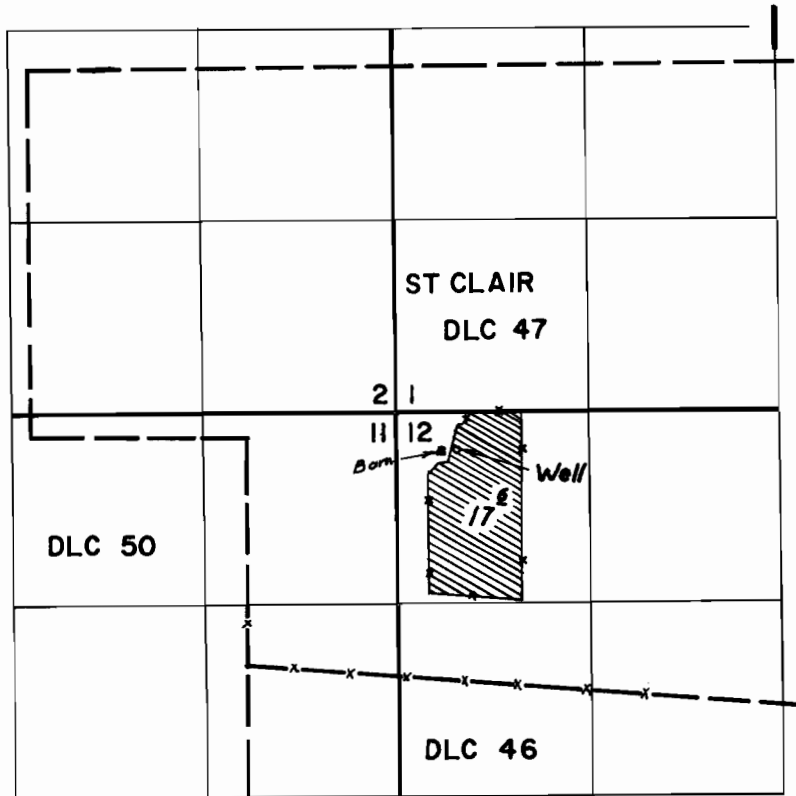

*Div. Pt. located: 1480 ft. S. & 1450 ft. E. from SW cor. St. Clair DLC 47*

**FINAL PROOF SURVEY**  
UNDER

Application No. G-3645 Permit No. G-3424  
IN NAME OF

MELVIN GARRIOT

Surveyed Jul. 1 1969, by L. E. Gould