


T. 11 S. R. 5 W. W. M.

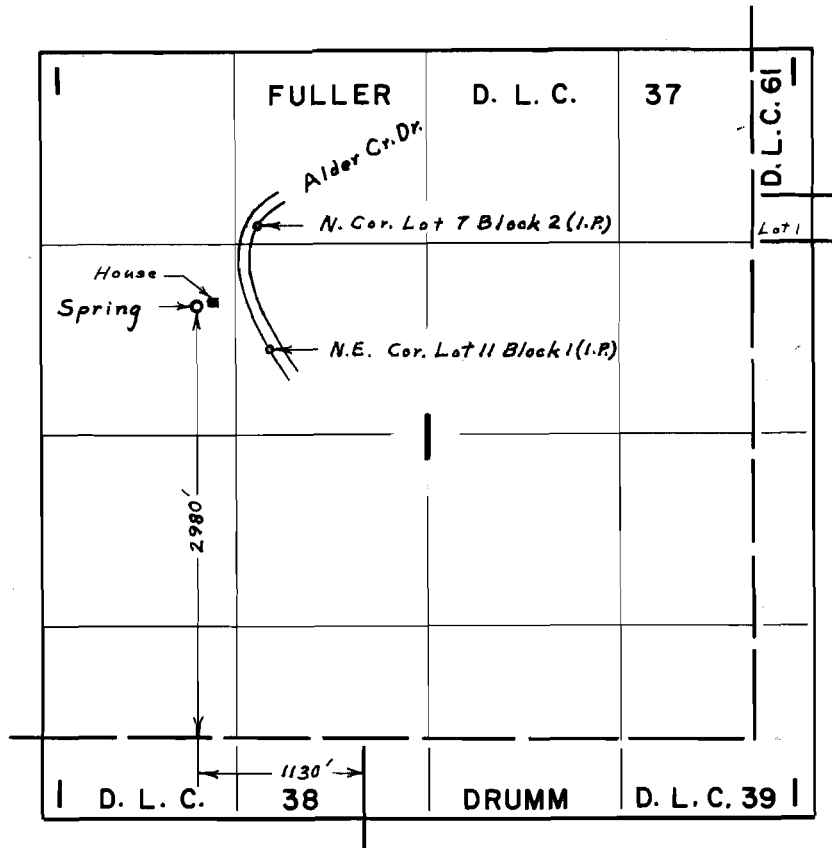

FINAL PROOF SURVEY
UNDER

Application No. 40290 Permit No. 30049
IN NAME OF

HUBERT STEWART

Surveyed July 24, 1969, by L. E. Gould