


T. 12 S. R. 6 W. W. M.

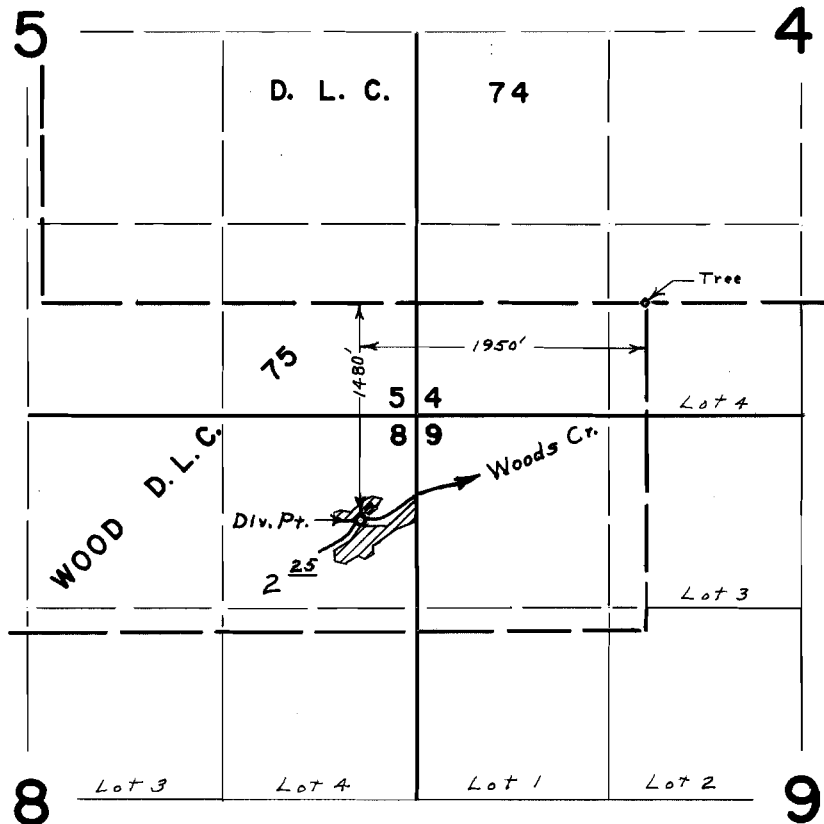

FINAL PROOF SURVEY
UNDER

Application No. 40697.. Permit No. 30315....
IN NAME OF

JACK ROTHACHER

Surveyed June 20, 1969., by L. E. Gould...