


# T.12&13 S. R.6 W. W.M.

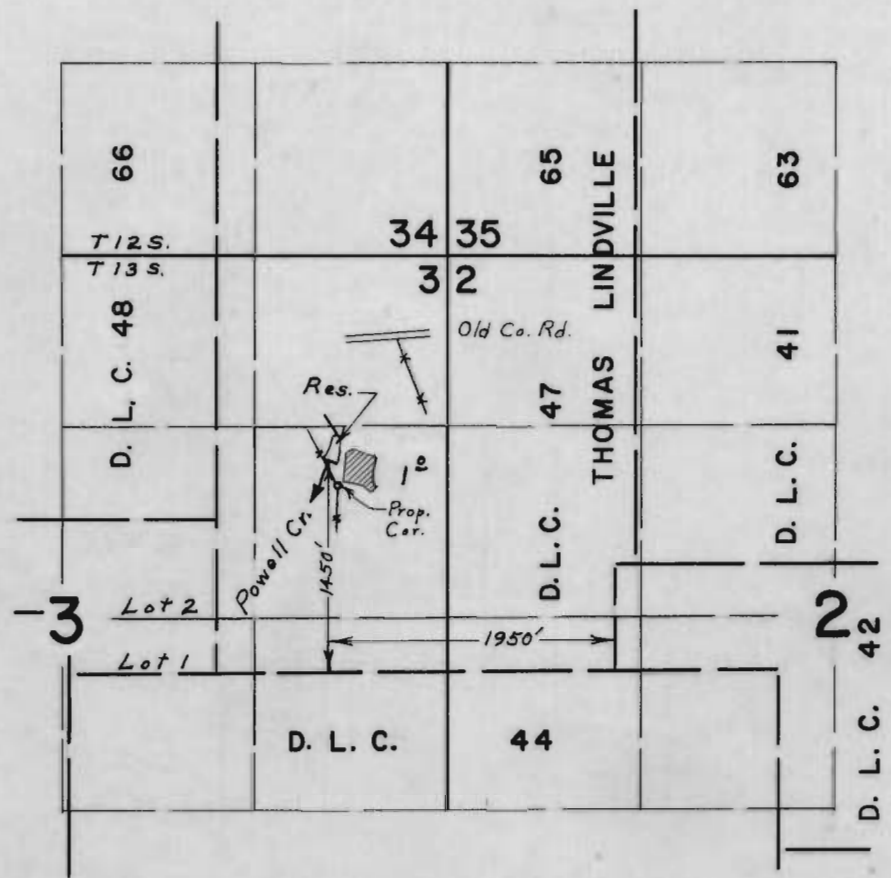

## FINAL PROOF SURVEY UNDER

Application No. 42120 Permit No. 31193  
IN NAME OF

**JOHN ROBERT BERRY**

Surveyed June 17, 1969, by L. E. Gould