


T. 12 S. R. 6 W. W. M.

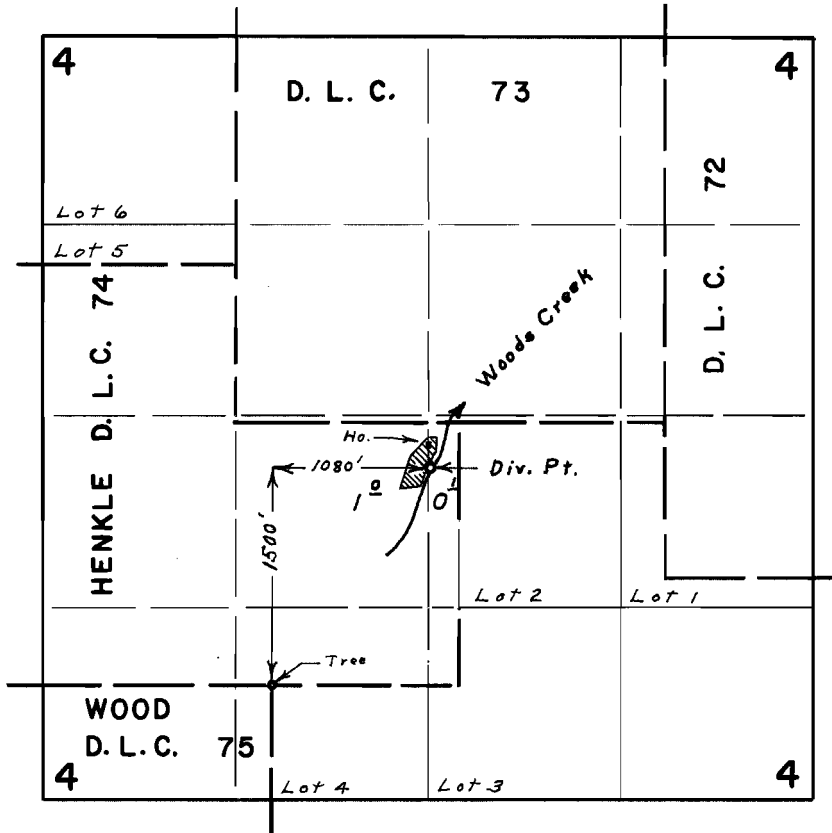

FINAL PROOF SURVEY UNDER

Application No. 43647 Permit No. 32629
IN NAME OF

JOHN KLOTZBACK

Surveyed June 30, 1969, by L. E. Gould