


T.11S.R.5W.W.M.

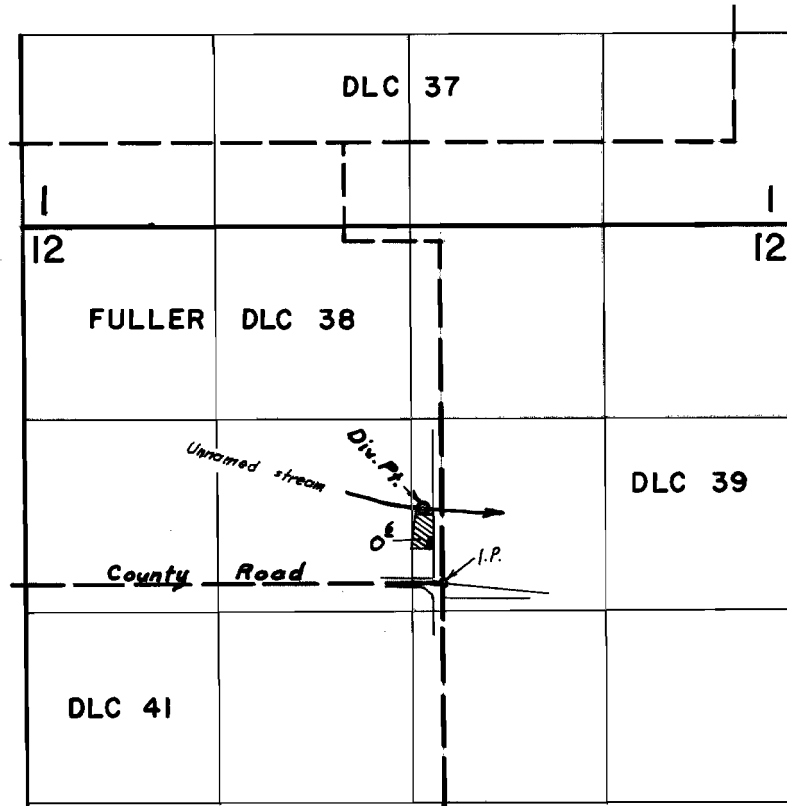

Div. Pt. located: 520 ft. N. & 130 ft. W. from SE cor. Fuller DLC 38.

FINAL PROOF SURVEY
UNDER

Application No. 43777 Permit No. 32712
IN NAME OF

FRED GOSKA

Surveyed Jul. 3 1969, by L.E. Gould