


T.29S.R.14W.W.M.

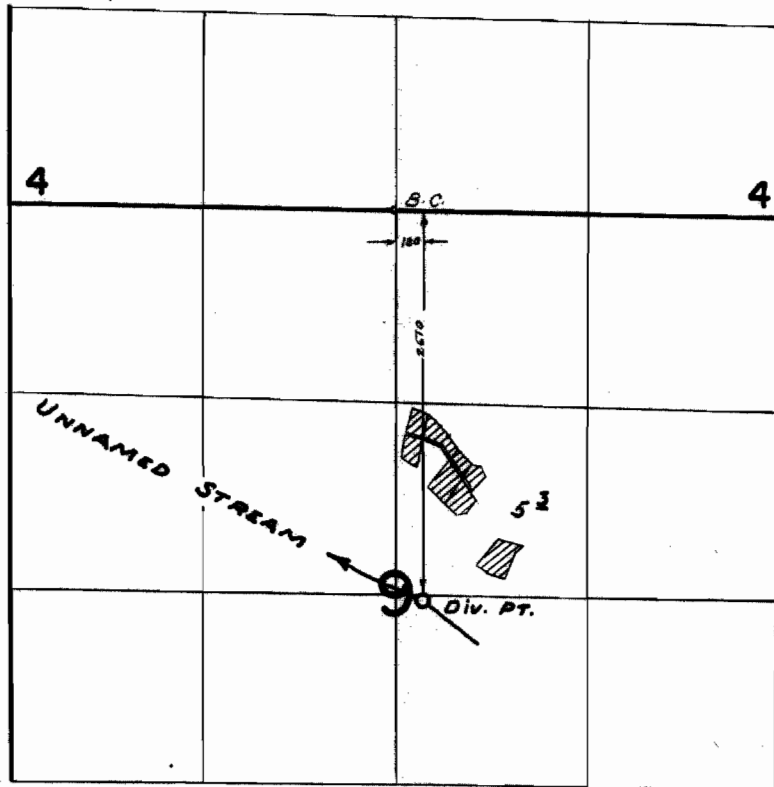

**FINAL PROOF SURVEY**  
UNDER

Application No. 35031 Permit No. 27437  
IN NAME OF

ERWIN RICHERT

Surveyed MAY 17, 1969, by W. RUPPERT