


T.28S.R.14W.W.M.

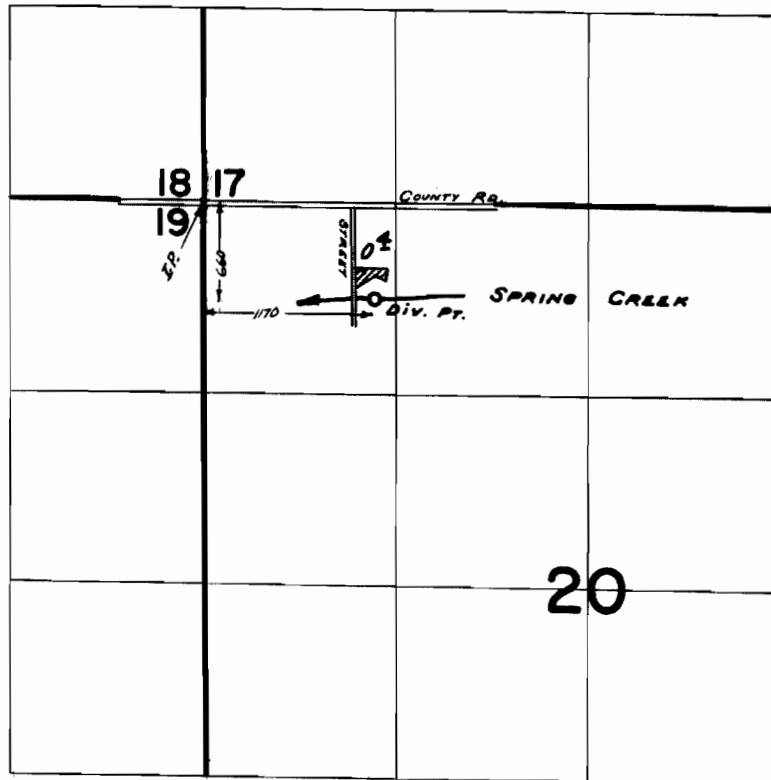

**FINAL PROOF SURVEY**  
UNDER

Application No. 43327 Permit No. 32397  
IN NAME OF  
**MEREDITH H. and GRACE MARTIN**

Surveyed May 19, 1969, by W. RUPPERT.