


T.41S. R.13W.W.M.

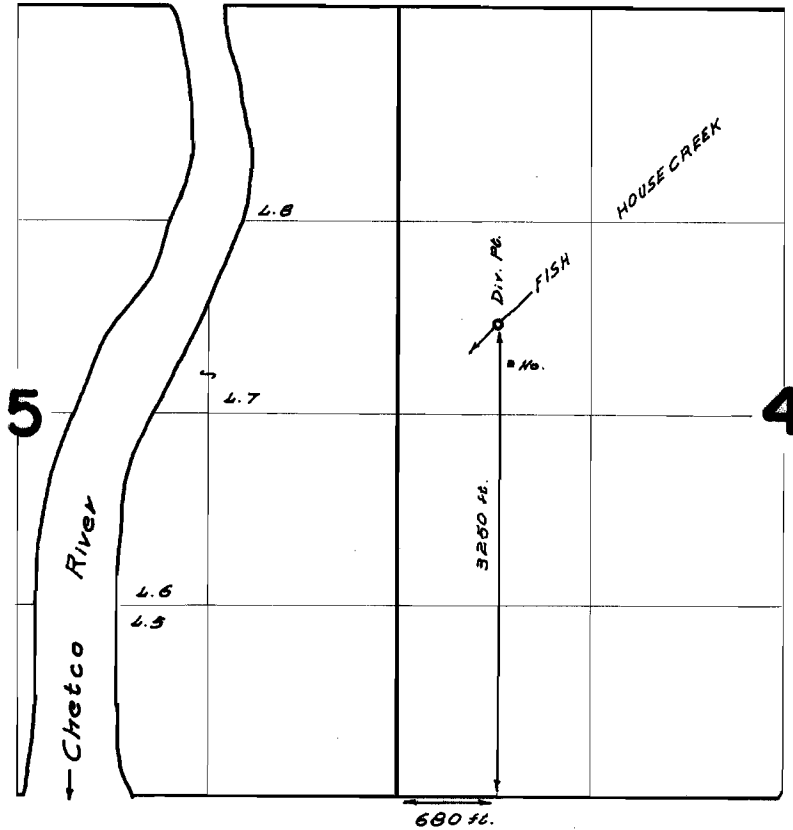

FINAL PROOF SURVEY
UNDER

Application No. 39200 Permit No. 29149
IN NAME OF

Lee F Gardner

Surveyed Sept 13 1966, by W. J. Ruppert