


T.30S.R.14W.W.M.

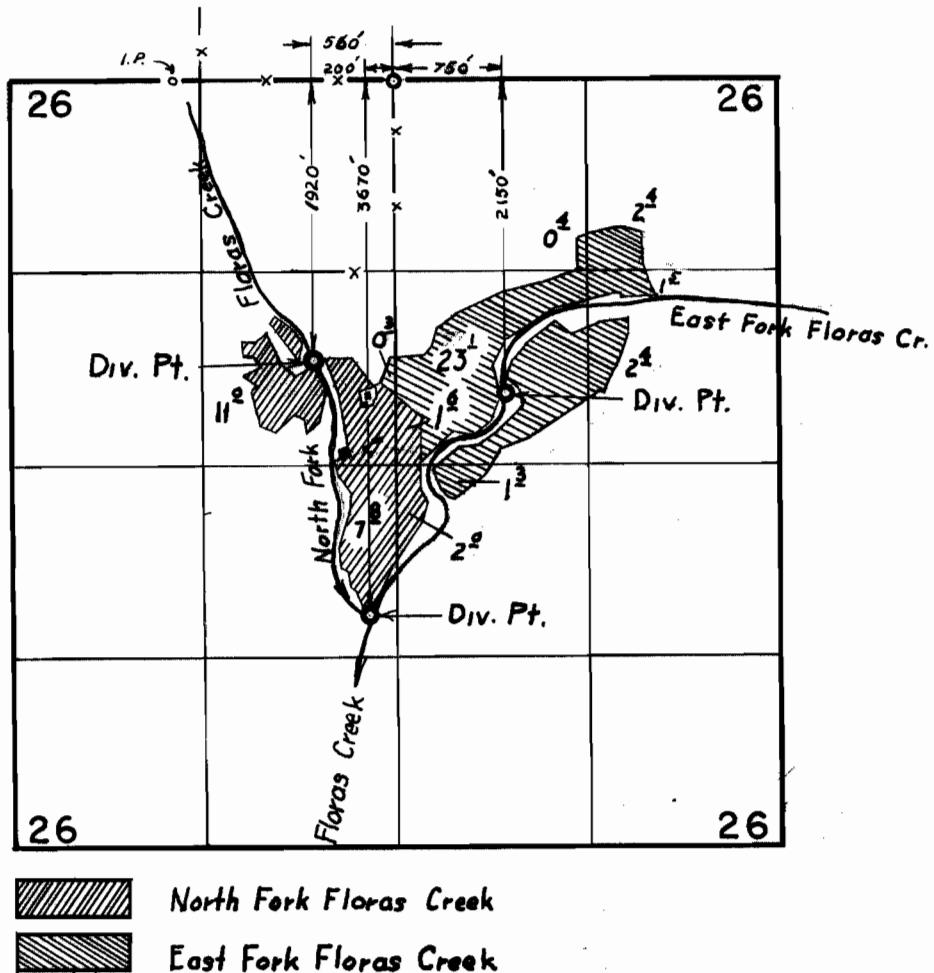

FINAL PROOF SURVEY
UNDER

Application No. 39712 Permit No. 29627
IN NAME OF

EVERETT ISENHART

Surveyed May 19 1969, by L. E. Gould