


# T. 33 S. R. 15 W. W. M.

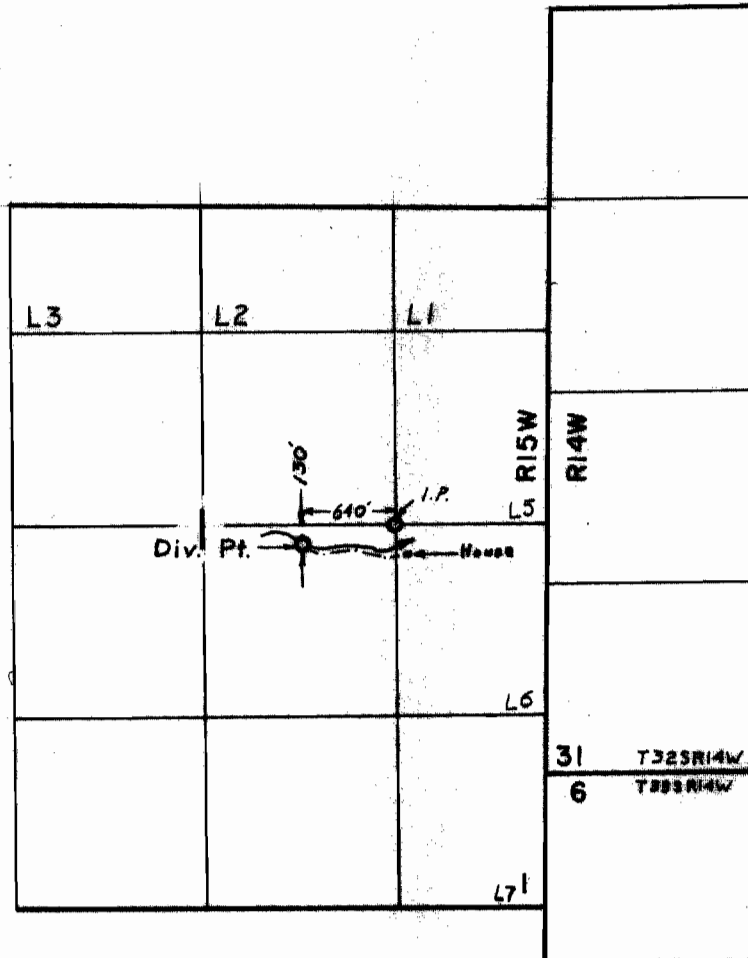

## FINAL PROOF SURVEY UNDER

Application No. 39762 Permit No. 29635  
IN NAME OF

JAMES M. WOODWARD, SR.

Surveyed May 20 1969, by L. E. Gould