


T.35S.R.14W.W.M.

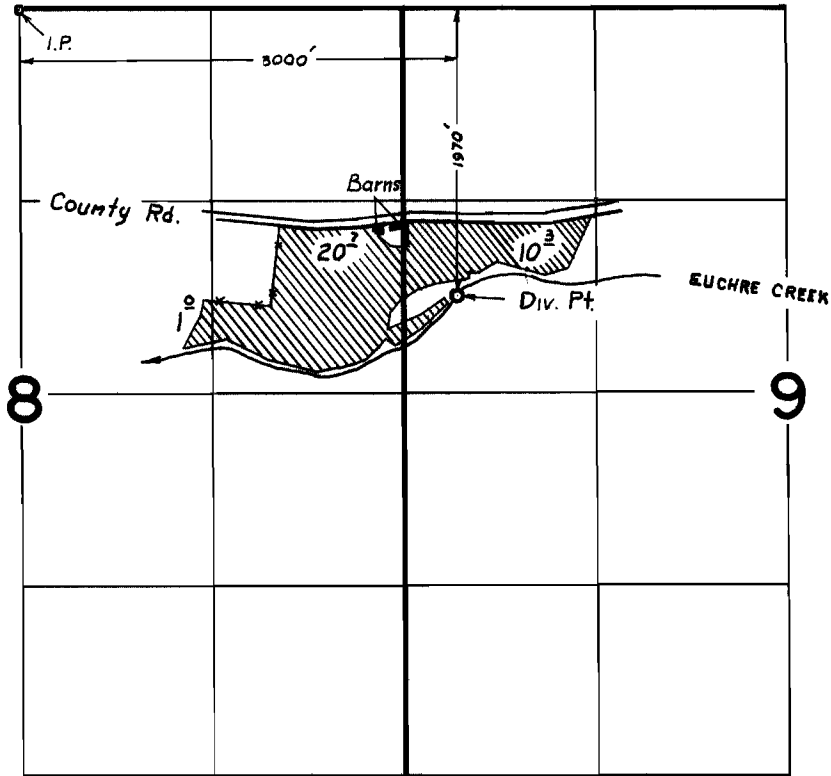

FINAL PROOF SURVEY UNDER

Application No. 39765 Permit No. 29636
IN NAME OF

FREDERIC H. STARKWEATHER, JR.

Sep 22 1966 W. J. Ruppert
Surveyed May 22, 1969, by L. E. Gould