


T.12S.R.6W.W.M.

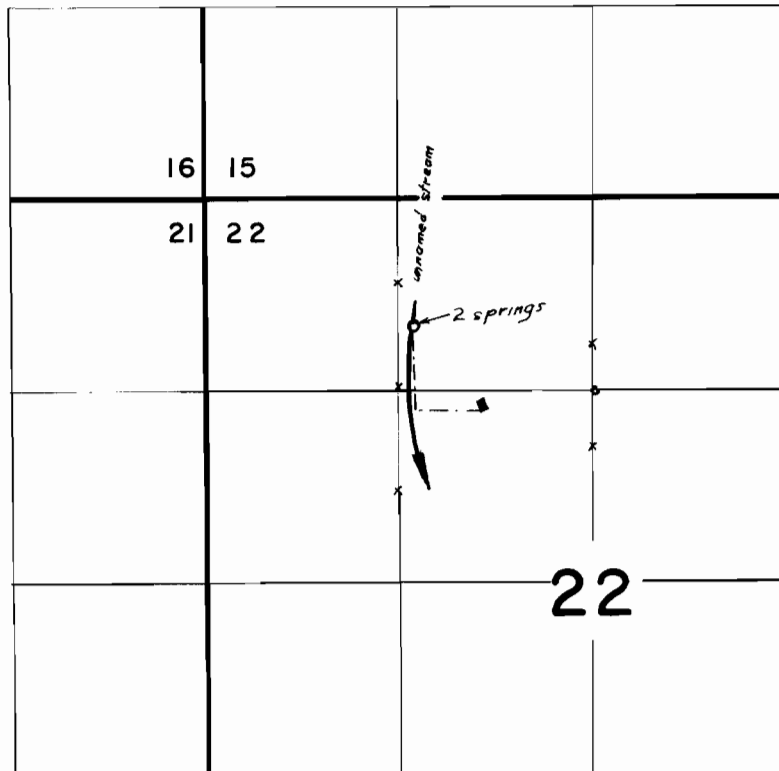

Springs located: 440 ft. N. & 1220 ft. W. from S.E. cor. NE 1/4 NW 1/4 Sec. 22.

FINAL PROOF SURVEY
UNDER

Application No. 41096 Permit No. 30723
IN NAME OF

GLEN D. & MARY O. DEALY

Surveyed July 3 1969 by L. E. Gould