


T.35S.R.14W.W.M.

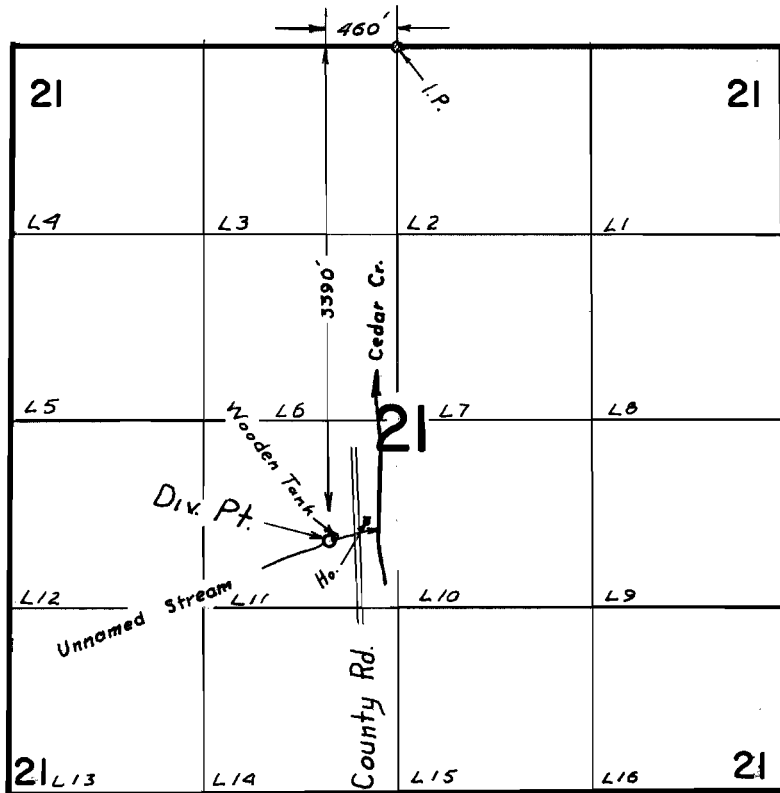

FINAL PROOF SURVEY UNDER

Application No. 42890 Permit No. 32054
IN NAME OF

JIM & SHIRLEY LeCLAIR

Surveyed May 23, 1969, by L. E. Gould