


T. 27 S. R. 6 W. W. M. .

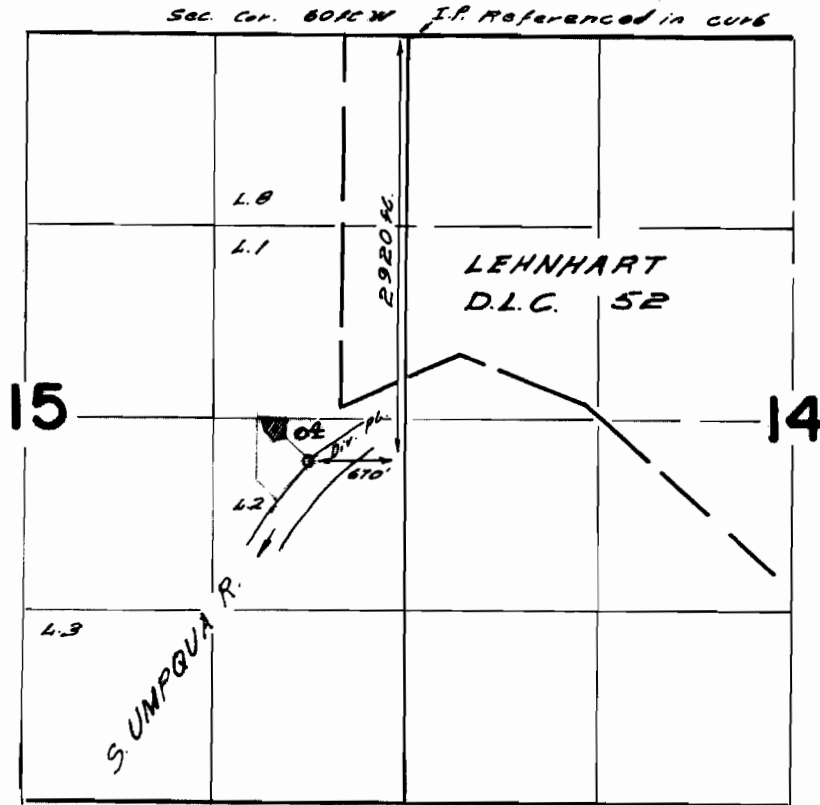

**FINAL PROOF SURVEY**  
UNDER

Application No. 34776 Permit No. 27298  
IN NAME OF

HOWARD V. & JAUNITA A. LONG

Surveyed July 12, 1967, by W. S. Ruppert