


T. 30S. R. 2W. W.M.

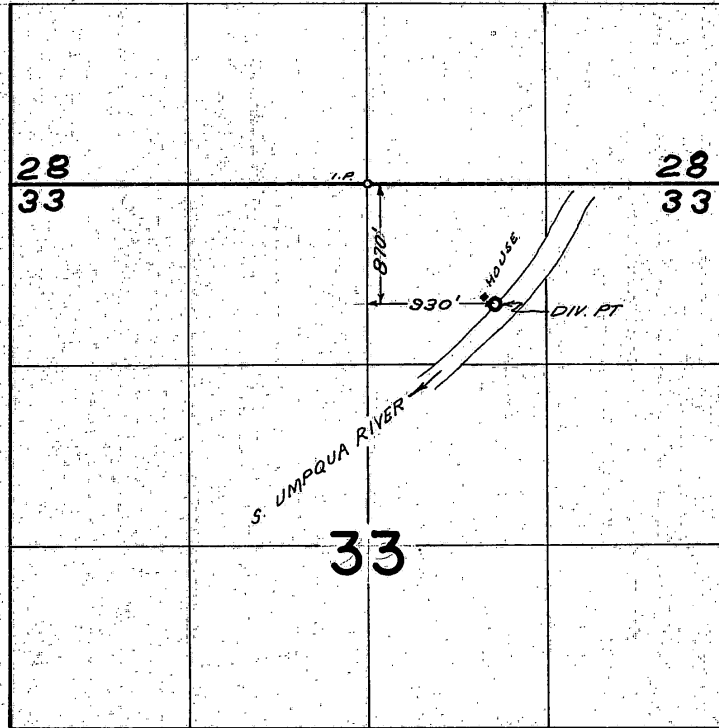

FINAL PROOF SURVEY
UNDER

Application No. 42933 Permit No. 32077
IN NAME OF

VERNON L. AND OLIVE E. McGINNIS

Surveyed APR. 16 1968, by V. GARNER