


# T. 28 S. R. 6 W. W. M.

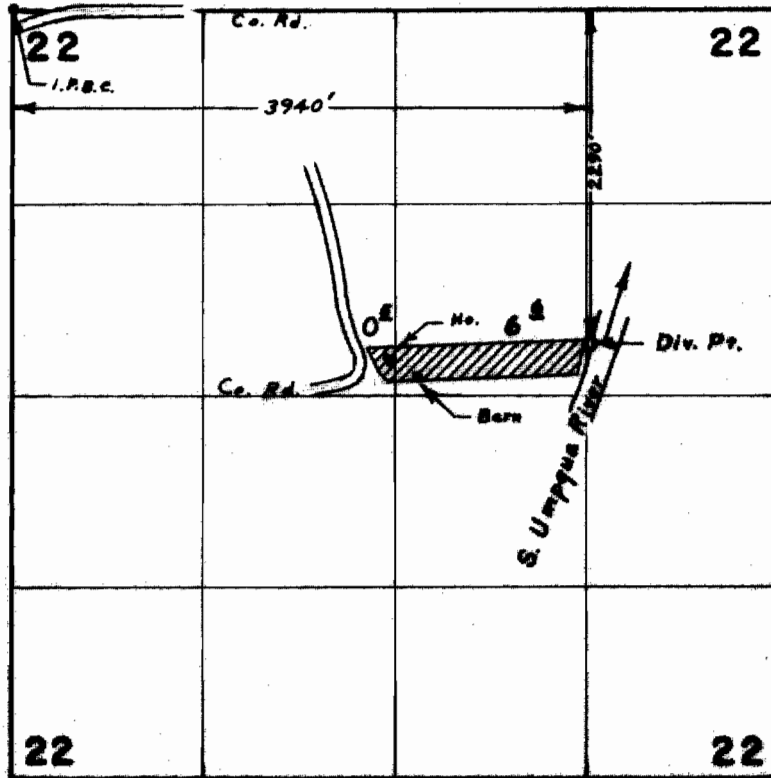

## FINAL PROOF SURVEY UNDER

Application No. 44706. Permit No. 33472.  
IN NAME OF

LELAND F. OLIVER

Surveyed Aug. 8, 1969, by L. E. Gould