


T. 25 S. R. 30 E. W.M.

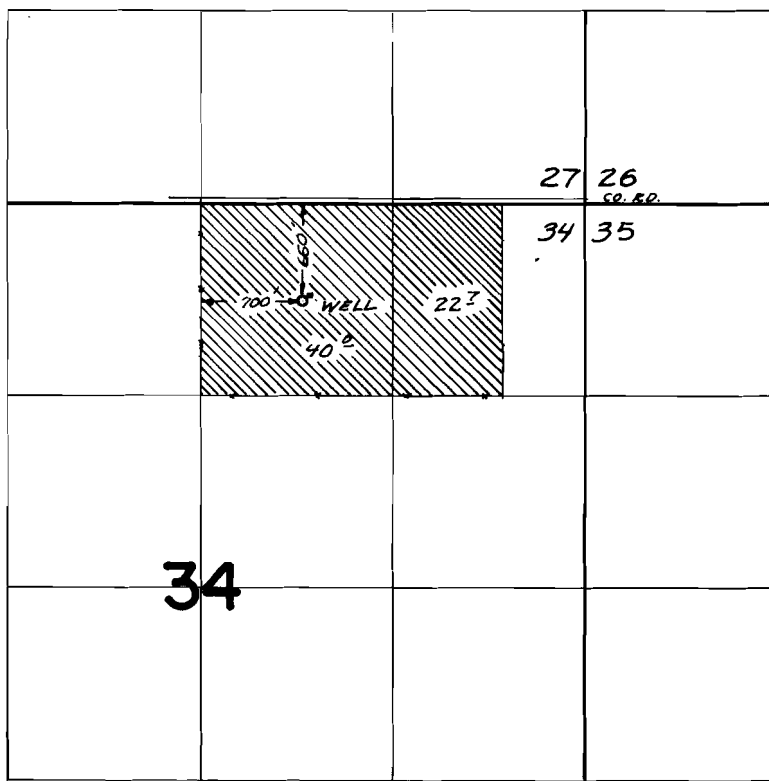

FINAL PROOF SURVEY
UNDER

Application No. G-1627 Permit No. G-1530
IN NAME OF

FORREST L. REED

Surveyed SEPT. 14, 1968, by V. Garner