T. 23 & 24 S. R. 34 E. W.M.

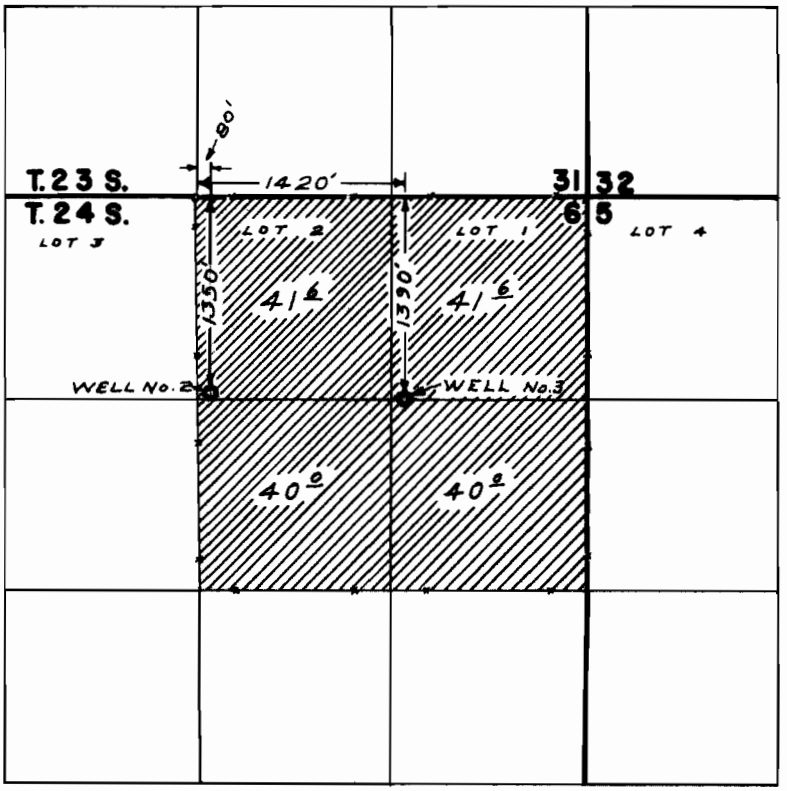

FINAL PROOF SURVEY
UNDER

Application No. G-4606 G-2528 Permit No. G-4330 G-2343
IN NAME OF

MILLER BROS.

Surveyed SEPT. 10 1968, by W. J. RUPPERT

1968-N
O.T.