


R 3964
36642

T.39S. R.19E.W.M.

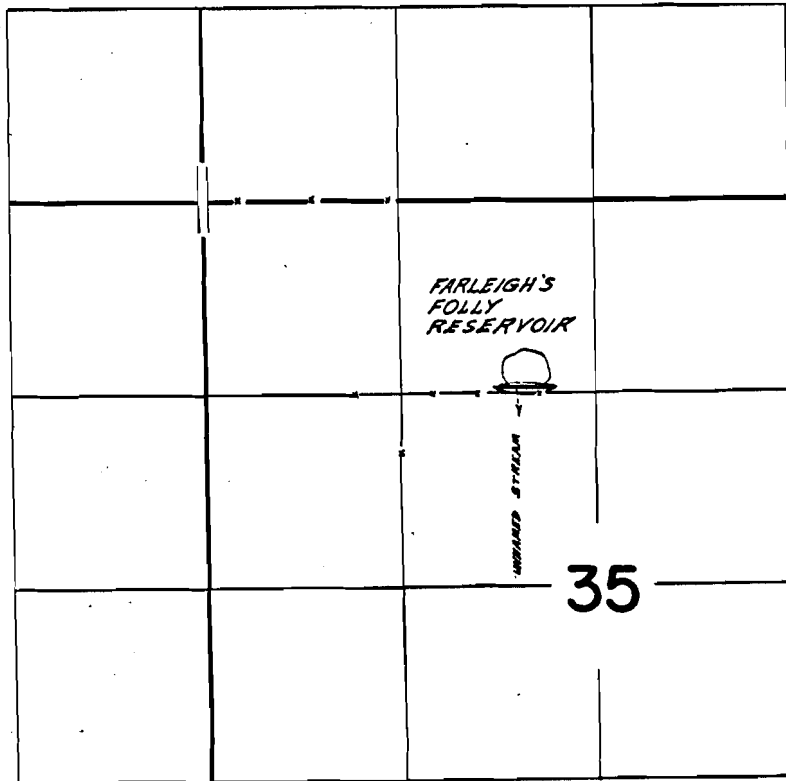

FINAL PROOF SURVEY UNDER

Application No. *R-39425* Permit No. *R-3964*
IN NAME OF

JAMES H. FARLEIGH

Surveyed July 31, 1968, by *W.D. Reppert*

39-19 ✓