


T.19 S. R.12 W. W.M.

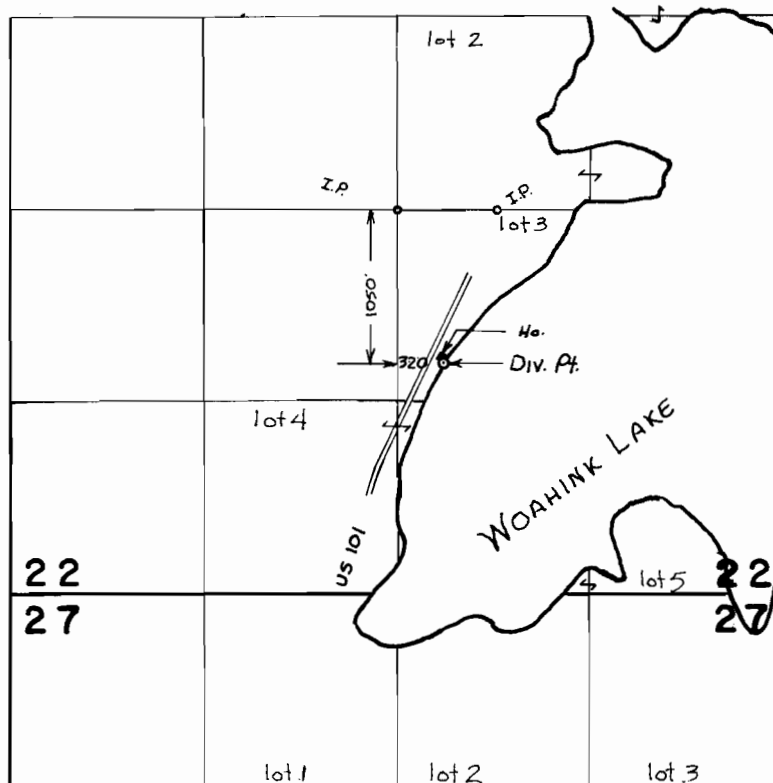

FINAL PROOF SURVEY
UNDER

Application No. 39254... Permit No. 29240...
IN NAME OF

CARMINE GALLO

Surveyed 5 AUG. . 1969 , by W. J. RUPPERT