


T. 19 S. R. 12 W. W. M.

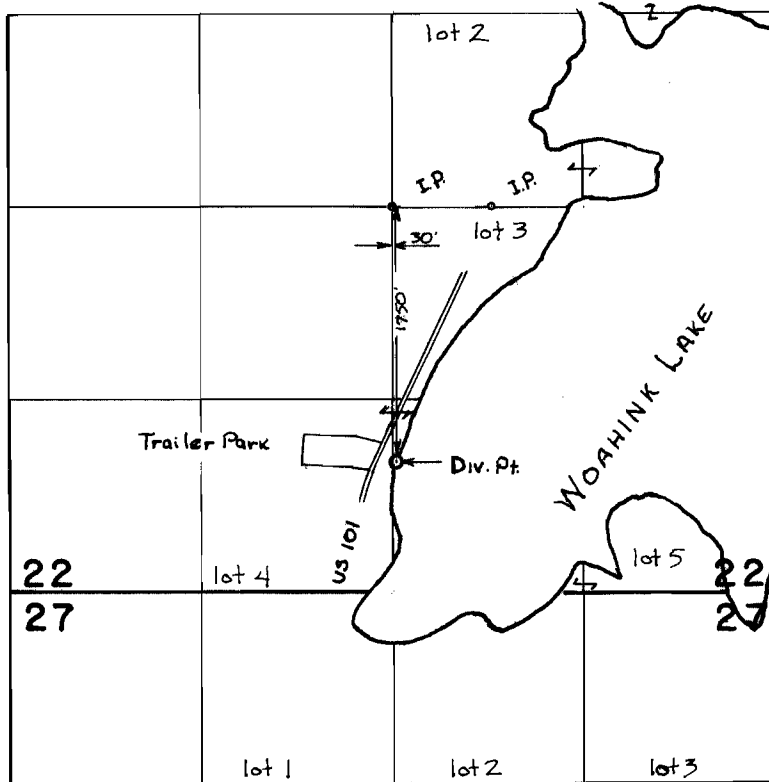

FINAL PROOF SURVEY
UNDER

Application No. 39243 Permit No. 29237
IN NAME OF

TED SIMMONEAU & E.H. ROBBINS

Surveyed 5 AUG. 1969, by W.J. RUPPERT