


T.18 S. R.10 & 11 W. W.M.

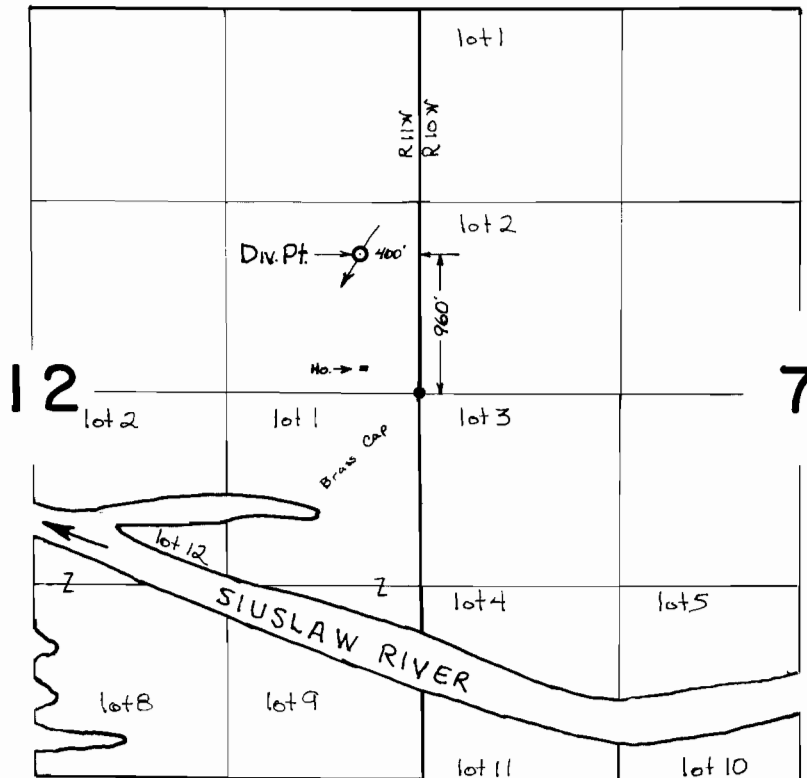

**FINAL PROOF SURVEY**  
UNDER

Application No. 42223... Permit No. 31605...  
IN NAME OF

**CHARLES F. SMITH**

Surveyed 6 AUG 1969, by W. J. RUPPERT.