


T.19 S. R.12 W. W.M.

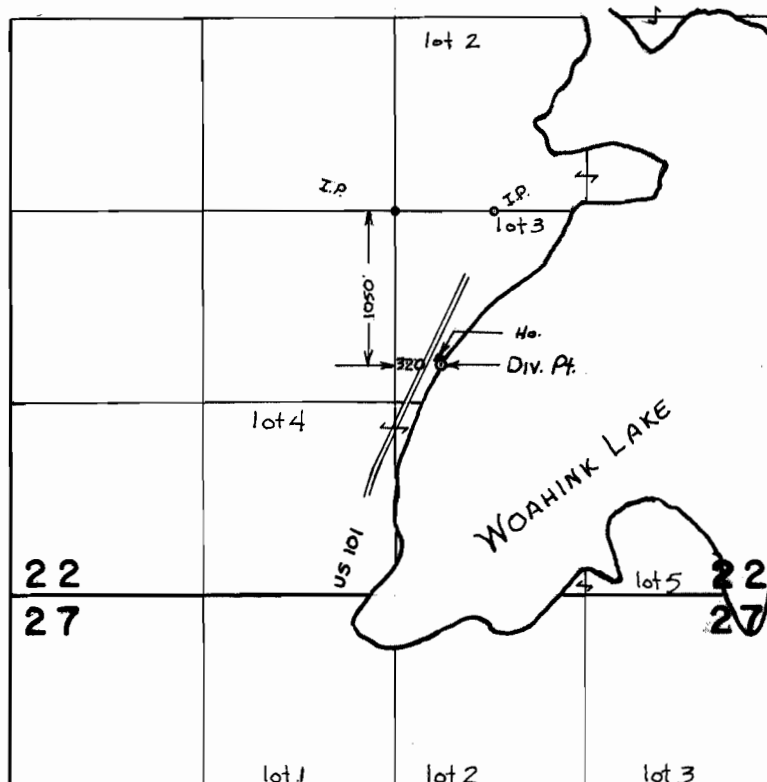

FINAL PROOF SURVEY
UNDER

Application No. 39254 Permit No. 29240
IN NAME OF

CARMINE GALLO

Surveyed 5 AUG 1969, by W. J. RUPPERT