


T.II S.R.II W.W.M.

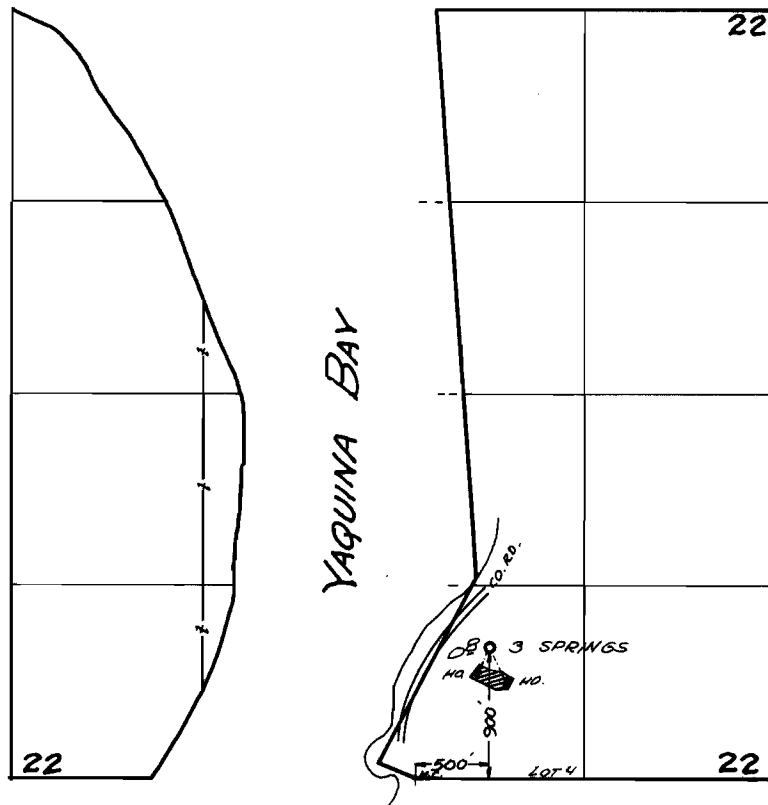

FINAL PROOF SURVEY
UNDER

Application No. 33865 Permit No. 26695
IN NAME OF

FRANCIS W. SMITH Sr., HELEN G. ESPY and FRANCIS W. SMITH Jr.

Surveyed Oct. 8, 1968, by V. Garner