


T.14S. R.9W. W.M.

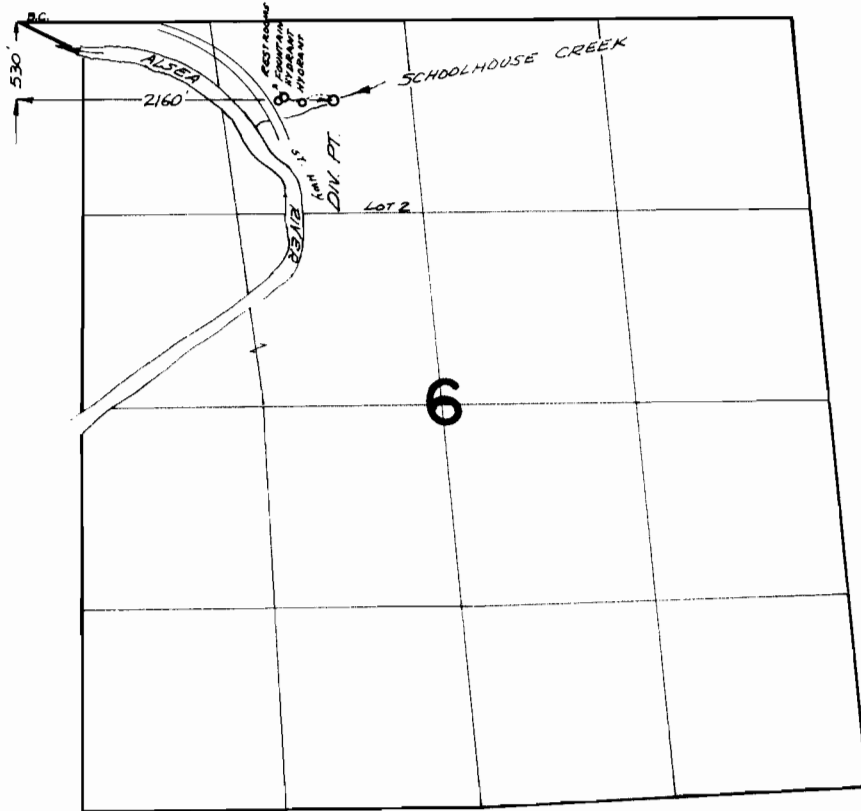

FINAL PROOF SURVEY UNDER

Application No. 39154 Permit No. 29342
IN NAME OF

U.S. FOREST SERVICE

Surveyed *Oct. 10. 1968*, by *V. Garner*