


T. 13 & 14 S. R. 10 W. W.M.

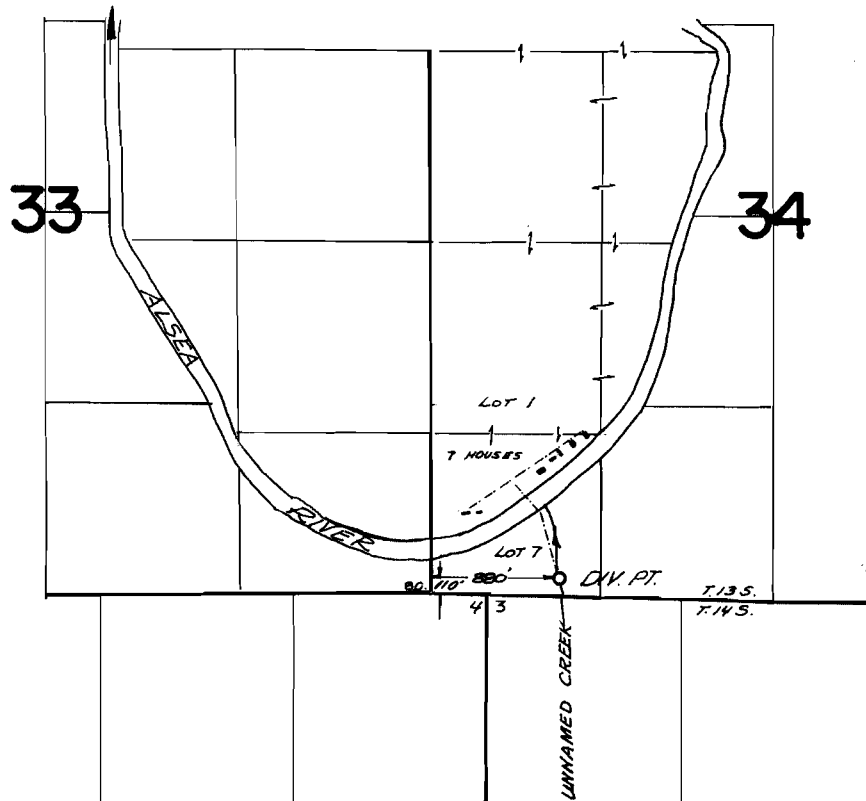

FINAL PROOF SURVEY UNDER

Application No. *40363*... Permit No. *30094*...
IN NAME OF

PAULSON TRACTS DISTRICT IMPROVEMENT COMPANY

Surveyed *Oct. 10*.. 1968., by *V. Garner*.....