


# T. 13 S. R. 3 W. W.M.

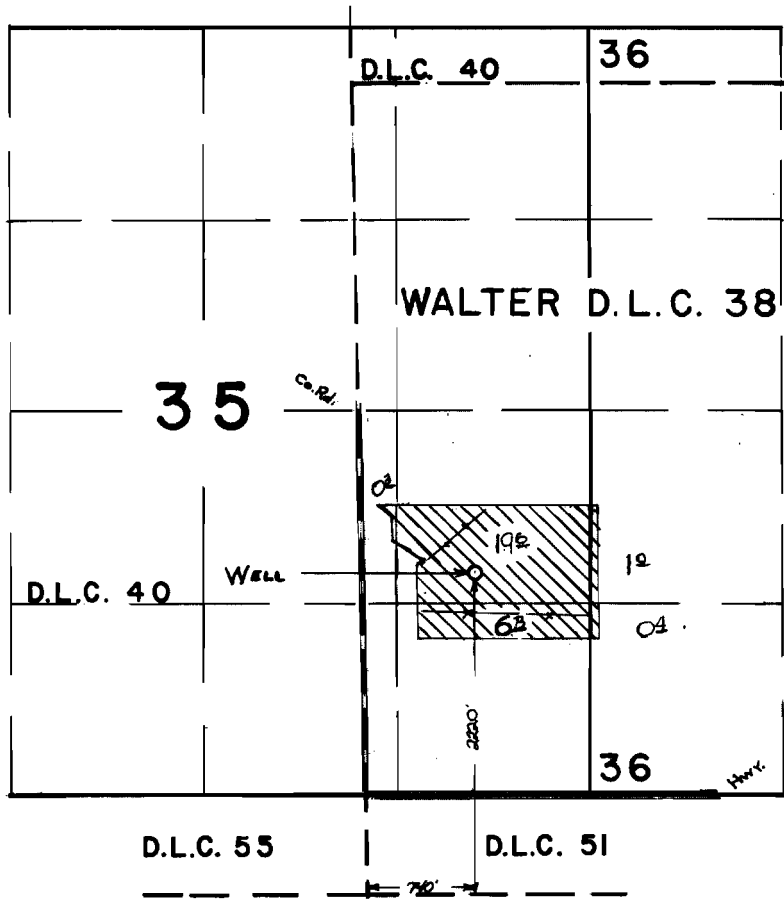

## FINAL PROOF SURVEY UNDER

Application No. G.2403. Permit No. G.2212.  
IN NAME OF

CLARK CHASTAIN

Surveyed 8 AUG. 1969., by W.J. RUPPERT.