


T. 12 S. R. 2 & 3 W. W. M.

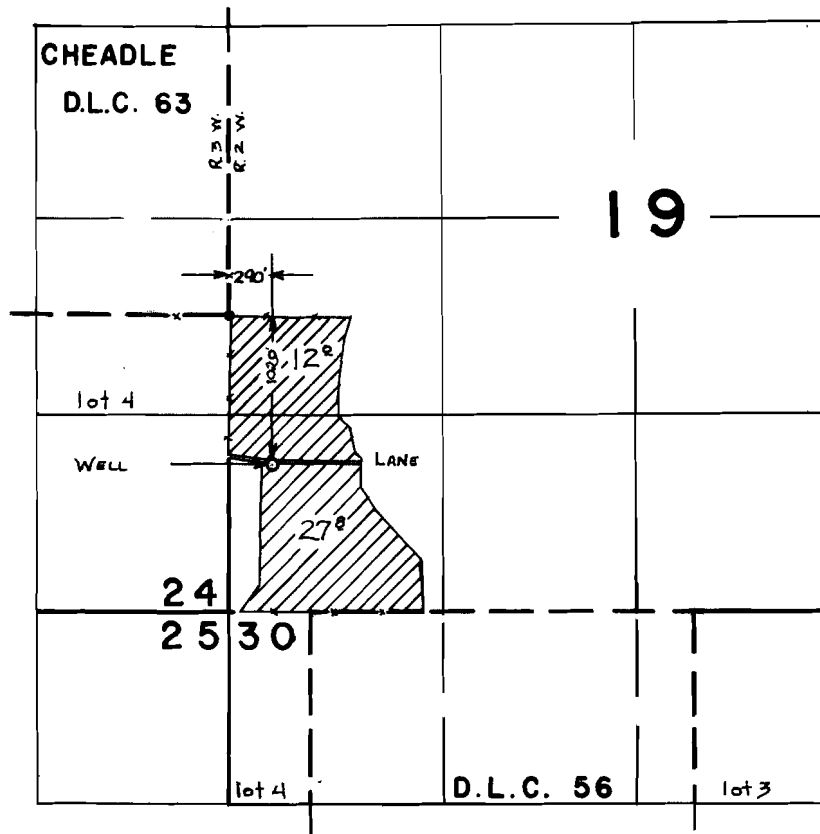

FINAL PROOF SURVEY
UNDER

Application No. G 4187. Permit No. G 3954.
IN NAME OF

SCOTT & EDITH WHEELER

Surveyed 11 AUG 1969, by W. J. RUPPERT