


# T. 16S. R. 4 W. W.M.

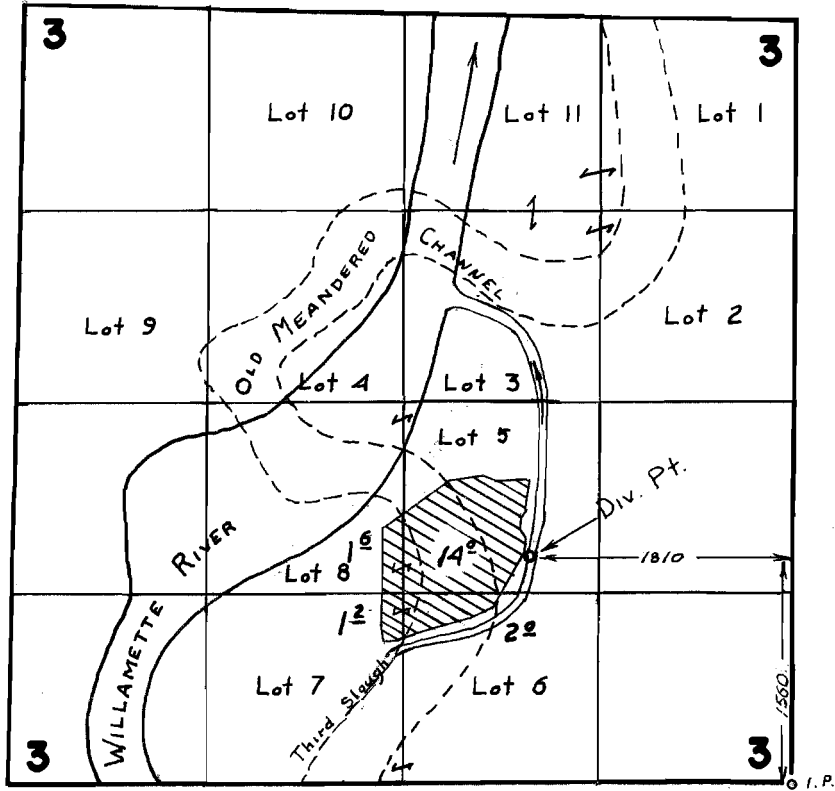

## FINAL PROOF SURVEY UNDER

Application No. 44550 Permit No. 33347  
IN NAME OF

EMERALD ACRES

Surveyed Apr. 23 19    , by L. E. Gould