


T.5S.R.1W. W.M.

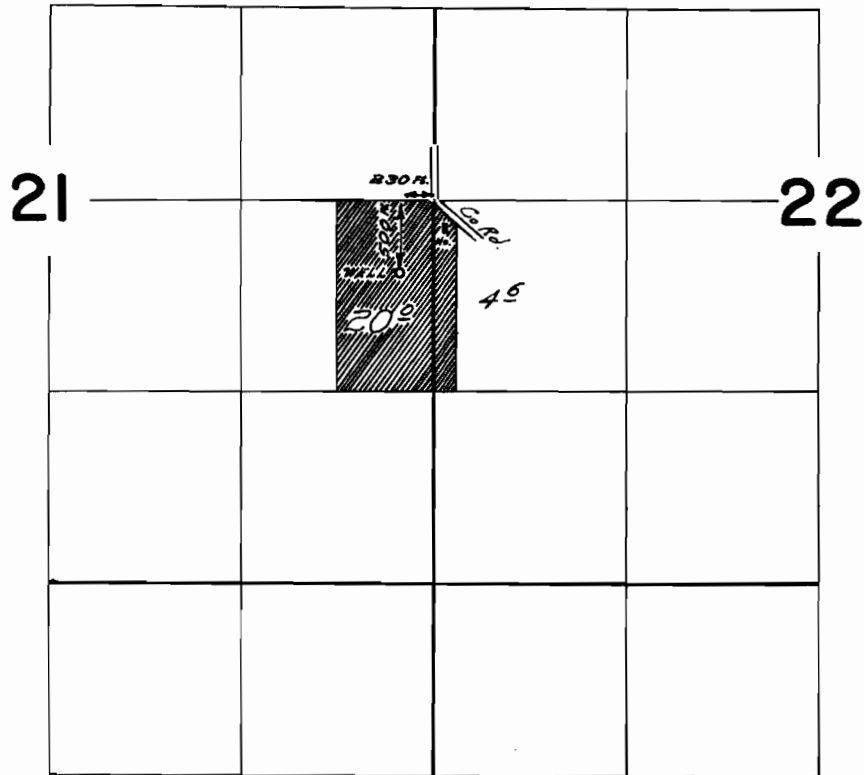

FINAL PROOF SURVEY UNDER

Application No. *G-3222* Permit No. *G-3033*
IN NAME OF
P. & M. NIKIFOROFF
E. & V. BAYANOFF

Surveyed *April 16, 1968*, by *W. d. Ruppert*