


T.6S.R.8W.W.M.

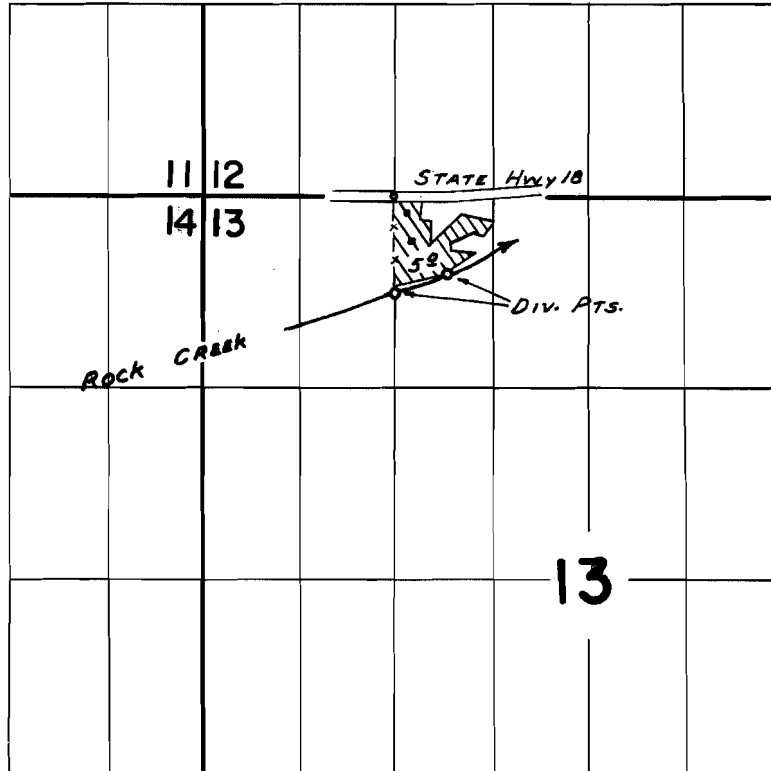

DIV. PTS. LOCATED 660 FT. S. & 10 FT. E. ; 520 FT. S. & 360 FT. E. ;
BOTH FROM NW COR. NE 1/4 NW 1/4 SEC 13

FINAL PROOF SURVEY UNDER

Application No. 39895 Permit No. 29695
IN NAME OF

ALBERT W. & LUCY G. WILKINS

Surveyed Nov. 28 1969, by D. BUELL