


T.9 S. R.5 W. W.M.

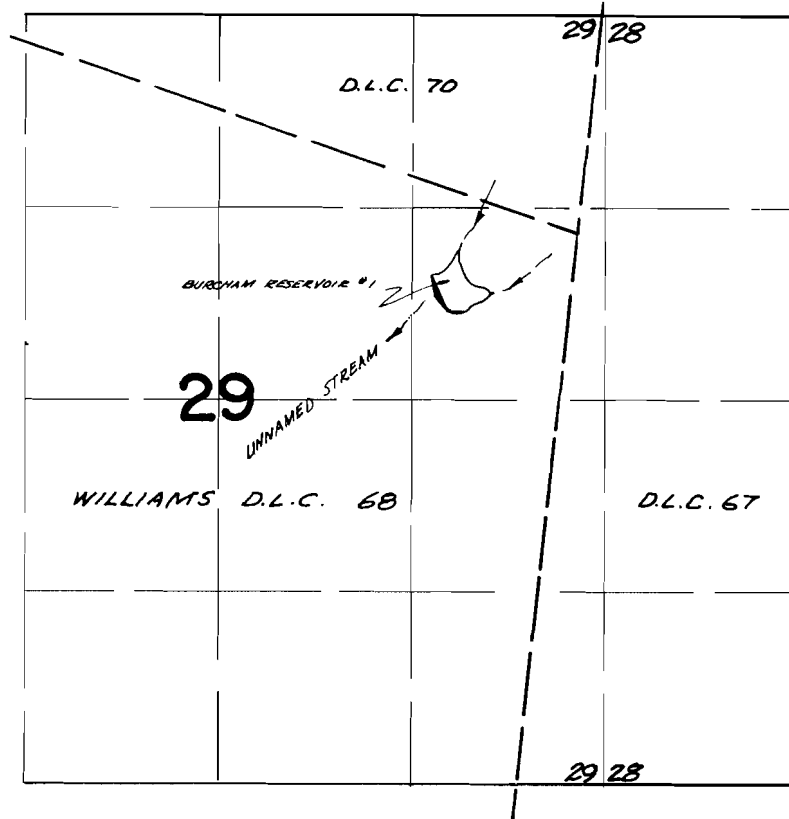

FINAL PROOF SURVEY UNDER

Application No. *R-42556*. Permit No. *R-4832*.
IN NAME OF

CLYDE BURCHAM

Surveyed *Sept 26 1968*, by *W. J. Ruppert*.