


T9 & 10S R4W.W.M.

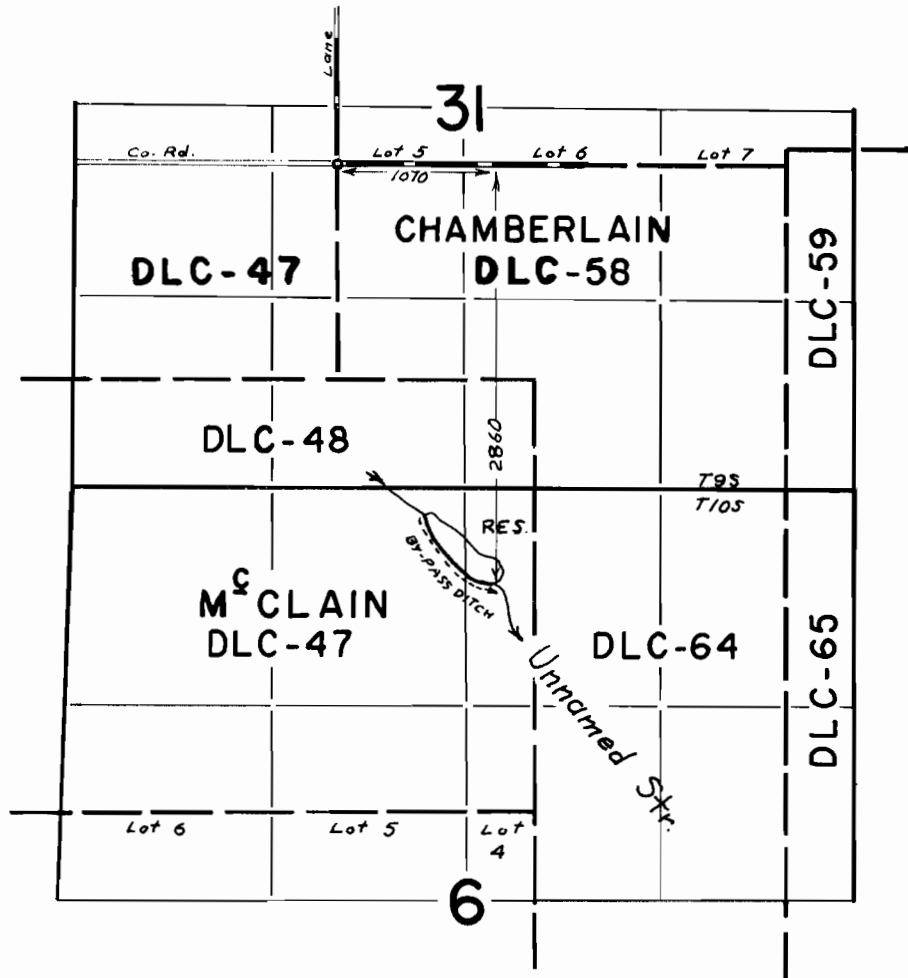

FINAL PROOF SURVEY UNDER

43075 32183
Application No. R-43074. Permit No. R-4904.
IN NAME OF

ALFRED FLICKINGER

Surveyed Mar. 28 1969, by D. R. BUELL