


T.6S,R.4W.W.M.

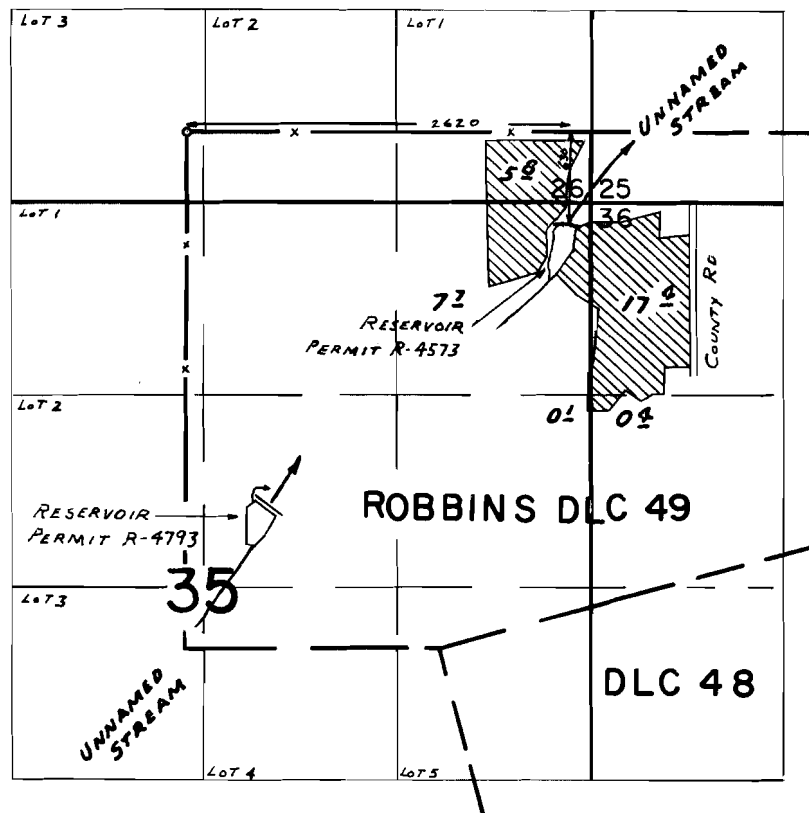

FINAL PROOF SURVEY

UNDER

40828

30416

R-40827

R-4573

Application No. R-42688 Permit No. R-4793

IN NAME OF

JAMES SMART MAPLE MOUND FARM

Surveyed Nov. 14 1969, by D. BUELL