


T. 6 S. R. 6 W. W. M.

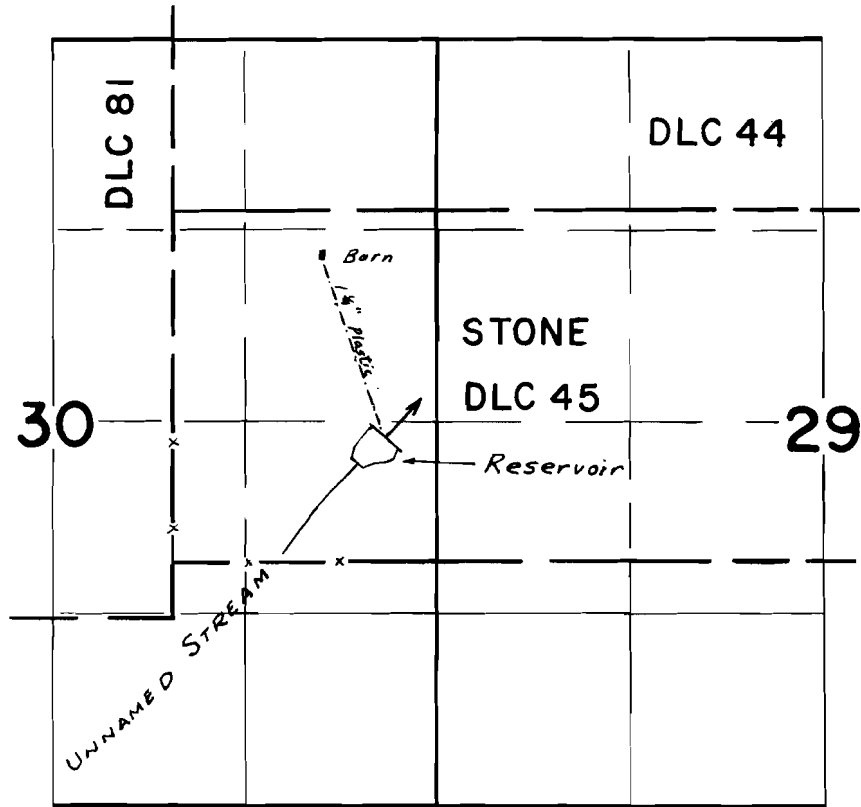

FINAL PROOF SURVEY
UNDER

Application No. *R-43604* Permit No. *R-5012*.
IN NAME OF

BILLY J. JONES

Surveyed *Nov. 26, 1969*, by *R. Mucken*.