


T.6S.R.7W.W.M.

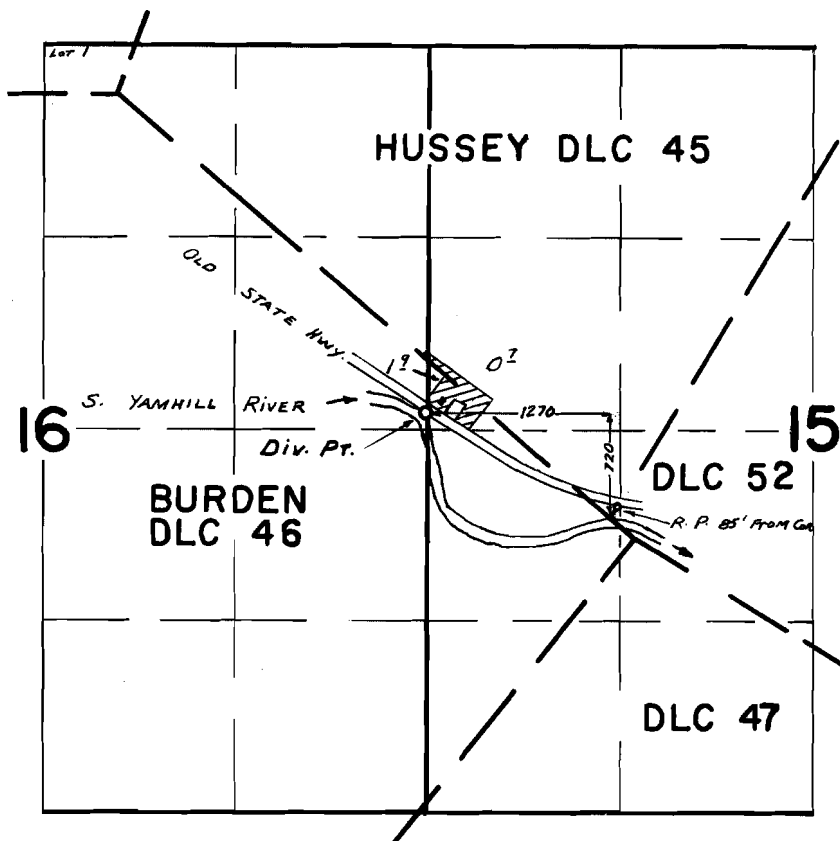

FINAL PROOF SURVEY UNDER

Application No. 44186 Permit No. 33015
IN NAME OF

JAMES L. BUSWELL

Surveyed Nov. 18 1969, by D. BUELL