


T.8S.R.5 & 6W.W.M.

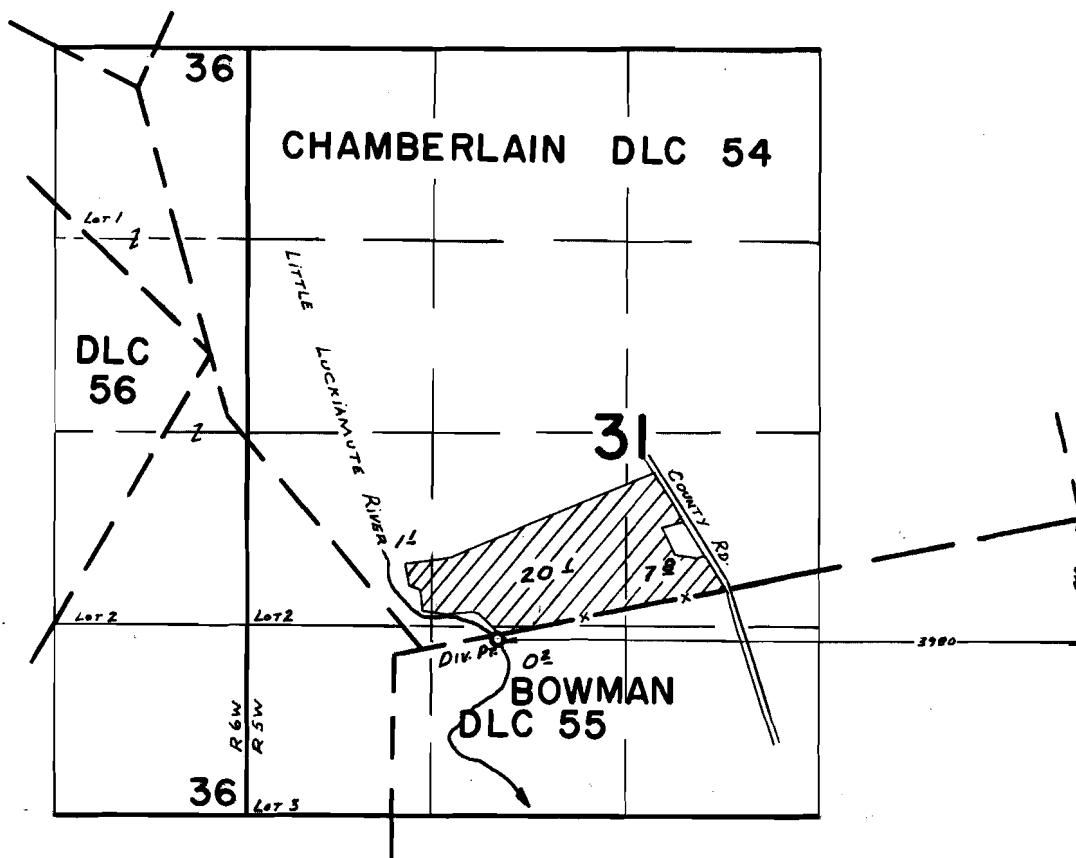

FINAL PROOF SURVEY UNDER

Application No. 44411 Permit No. 33174
IN NAME OF

NINA BRESSLER

Surveyed APR 10 1969, by D. BUELL